ADDENDUM NO. 4

NOVEMBER 11, 2026

CITY OF HIGHLAND VILLAGE

HIGHLAND SHORES BOULEVARD
RECONSTRUCTION PROJECT
From Twin Coves Drive/Hillside Drive to 200'± West of Lake Cove

---

SPECIFICATIONS

1. Change any and all references regarding bid date and time from "2:00 p.m. on November 19, 2026" to "2:00 p.m. on November 20, 2026".

2. Delete PF-1 and PF-2 and replace with the attached PF-1 and PF-2.

3. Delete the Bid Schedule and replace with the attached Bid Schedule.

PLANS

4. On Sheet No. 2, replace General Note 25 with the following note:

   "25. ALL EXCAVATION SHALL BE UNCLASSIFIED EXCAVATION FOR PAYMENT PURPOSES. THE TOP 4 INCHES OF SOIL SHALL BE STRIPPED AND STOCKPILED ON THE SITE ANS SPREAD OVER THE SITE AS TOP SOIL DURING FINAL GRADING."

5. On Sheet No. 3, replace Turf Note with the following notes:

    "1. ALL DISTURBED EARTH AREAS ARE TO BE FINISH GRADED TO ORIGINAL OR PROPOSED CONTOURS, FERTILIZED AND COVERED WITH SOLID SOD/HYDROMULCH ACCORDING TO THE CONSTRUCTION PLANS AND NCTCOG SPECIFICATIONS IMMEDIATELY AFTER CONSTRUCTION. FOR AREAS TO BE COVERED WITH SOLID SOD, THE CONTRACTOR SHALL REMOVE A TOTAL OF 5 INCHES OF SOIL BELOW FINISH GRADE AND REPLACE WITH 4 INCHES OF TOP SOIL AND SOLID SOD. AREAS TO BE COVERED WITH HYDROMULCH THE CONTRACTOR SHALL ENSURE TOP 4 INCHES OF SOIL IS TOP SOIL. ALL FILL/TOP FILL MATERIAL SHALL BE FREE OF ROCK AND OTHER DEBRIS. CONTRACTOR SHALL THOROUGHLY WATER SOD/HYDROMULCHED AREAS IMMEDIATELY AFTER PLACEMENT. THE CONTRACTOR SHALL ALSO BE RESPONSIBLE FOR CONTINUED MAINTENANCE AND WATERING OF THE NEWLY SODDED AREAS UNTIL THE ENTIRE PROJECT IS COMPLETED AND ACCEPTED BY THE CITY OF HIGHLAND VILLAGE. WATERING OF THE SOD AREA SHALL BE DONE IN A MANNER AND AREA SHALL BE DONE IN A MANNER AND QUANTITY AS DIRECTED BY CITY OF HIGHLAND VILLAGE INSPECTION PERSONNEL (NO SEPERATE PAY).

6. Replace Construction Details Sheet No. 5 with Attached Sheet.

7. Replace Detour Plan Sheet No. 26 with Attached Sheet.

8. Replace Sidewalk 'A' Plan and Profile Sheet No. 81 with Attached Sheet.

9. Replace Drainage Plan and Profile Sheet No. 100 and Sheet No. 110 with Attached Sheets.

CLEARIFICATIONS

10. Bid item 48 "Place 8" Thick Aggregate Base (TxDOT Item 247)" includes removal of excess material (8" thick) that is not to be paid as part of bid item 32 "Unclassified Street Excavation" but removal of excess 8" thick material shall be considered subsidiary to bid item 48 "Place 8" Thick Aggregate Base (TxDOT Item 247)"

11. An updated Excel version of Bid Schedule (Addendum No. 4) has been provided on CivCast for contractor's convenience. Contractors are NOT required to us the Excel Bid Schedule.

12. Change all references of Cement Stabilized Base to Cement Treated Base.

13. Contractors are NOT required to be pre-qualified with TxDOT.

14. A Bid bond is required as part of the bid summation but there is not a specific bid bond form required.

15. Multi-piece tiebars per TxDOT specification will be allowed (no additional pay).

16. The City will require the majority of the pavement to be placed by a mechanical method. Hand placed concrete will be limited to transition areas where mechanical methods will not work. The use of vibratory truss screeds are allowed and shall follow NCTCOG requirements (NCTCOG 303.4).

17. Certificate on Interested Parties form is not required to be submitted with the bid submission.

18. Excavation items (item 32 "Unclassified Street Excavation" and item 33 "Barrow") does not include non-soil materials. Non-soil material removals and placements shall be paid for by other items.

19. Per PF-2 Note 7. "Contractor will be paid for the quantities actually furnished and installed and for the work actually completed." This includes Excavation items (item 32 "Unclassified Street Excavation" and item 33 "Barrow"). Bid Schedule quantities are an estimated quantity. Method used for estimating Excavation items are based on average end areas. See NCTCOG 203.2 and 203.4 for additional specifications.

20. Per NCTCOG 108.2 "Work shall be done only during the hours between 7:00 am and 6:00 pm" The work area is in a residential area and overnight/Sunday work will not be permitted.

21. Per NCTCOG all hand finished concrete shall have an additional 1 sack of cement per cubic yard.

22. Sidewalk adjacent to toe wall, fill wall, and curbs shall be paid by Sidewalk Pavement by S.Y. (items #37, #38 and #39)

23. Bid Item 126, "Box Culvert Spalling Repairs" repair extend shall be determined in the field.

24. Contractor is permitted to use the Street ROW as well as 5001 FM2499/Village Parkway at no cost. No metal fencing is authorized at the 5001 FM2499/Village Parkway site. Contractor shall return staging area to pre-construction condition.

25. Concrete batch plant may be allowed within City limits. Contractor shall select a proposed site that is not within a residential area. Contractor shall submit request for batch plant site for City approval as part of the bid proposal.

26. General detail for block retaining wall has been provided on Sheet 95. Contractor shall submit shop drawing to the City for review.

BID FORM

_____ , 2026

TO: The Honorable Mayor and City Council
City of Highland Village, Texas

RE: City of Highland Village, Texas
Highland Shores Boulevard Reconstruction Project
From Twin Coves Drive/Hillside Drive to 200'± West of Lake Cove

Gentlemen:

The undersigned bidder, having examined the plans, specifications and contract documents, and the location of the proposed work, and being fully advised as to the extent and character of the work proposes to furnish all equipment and to perform labor and work necessary for completion of the work described by and in accordance with the Plans, Specifications and Contract Documents for the following prices, to wit:

Signed by: _____

ACKNOWLEDGMENT OF ADDENDA:

The Bidder acknowledges receipt of the following addenda:

Addendum No. 1 _____

Addendum No. 2 _____

Addendum No. 3 _____

Addendum No. 4 _____

Addendum No. 5 _____

NOTES:

1. All items, labor, materials, equipment, facilities, additional mobilizations, incidentals and work required for construction of the project are to be provided and installed by the Contractor as part of the project and payment for the cost of such shall be included in the price bid for the construction of the project.

2. Prices must be shown in words and figures for each item listed per unit in this proposal. In the event of a discrepancy, the words shall control.

3. Materials, which are "tax exempt," are those items, that are physically incorporated into the facilities constructed for the CITY, as set forth in the Special Provisions. Materials include, but are not limited to purchased items such as paint, etc.

4. Services, which are "not tax exempt," are those items, which are used by the Contractor but are not physically incorporated into the CITY's facility and/or items, which are consumed by construction, as set forth in the Special Provisions. Services include, but are not limited to, items such as supplies, tools, skill and labor, the purchase, rental or lease of equipment, etc.

5. Contractor shall provide CITY with breakdown of materials and services upon request by CITY, for pay estimate purposes.

6. Bid items in each instance shall include all items required to provide a facility that will operate safely, properly, and efficiently.

7. Contractor will be paid for the quantities actually furnished and installed and for the work actually completed.

8. Bid item 125 "Irrigation Repairs Allowance" represents an allowance to repair and/or relocate existing Irrigation Elements (not including Irrigation Control Valves; paid under bid item 28). Contractor shall coordinate with the City and provide a quote for City approval. Contractor shall obtain City approval prior to commencing any work related to "Irrigation Repairs Allowance". Contractor shall submit "Irrigation Repairs Allowance" invoice for City to process with a markup amount not-to-exceed 15% to cover and compensate the Contractor for profit, overhead, general supervision, and all other cost.

9. Bid item 48 "Place 8" Thick Aggregate Base (TxDOT Item 247)" includes removal of excess material (8" thick) that is not to be paid as part of bid item 32 "Unclassified Street Excavation" but removal of excess 8" thick material shall be considered subsidiary to bid item 48 "Place 8" Thick Aggregate Base (TxDOT Item 247)"

CITY OF HIGHLAND VILLAGE
HIGHLAND SHORES BLVD RECONSTRUCTION PROJECT
(Twin Cove Drive/Hillside Drive To 200' West of Lake Cove)

BASE BID SCHEDULE

Item No.	Est. Quantity	Unit	Description & Unit Price in Words	Unit Price in Figures	Extended Amount
SCHEDULE 'A' - CONTROLS/DEMOLITION/PREPARATION					
1	1	L.S.	Mobilization, Bonds, Insurance and all Permitting (entire project), complete, per unit _____ _____Dollars & _____Cents	$_____	$_____
2	1	L.S.	All Traffic Control Measures, including, but not limited to, construction sequencing, barricading, traffic control design, panels, signs, and temporary pavement markings, complete in place, per unit _____ _____Dollars & _____Cents	$_____	$_____
3	1	L.S.	Temporary Erosion Control, including providing SWPPP, NOI, and filing with TCEQ, complete in place, per unit _____ _____Dollars & _____Cents	$_____	$_____
4	2	EA.	Project Sign, complete, per unit _____ _____Dollars & _____Cents	$_____	$_____
5	21,800	S.Y.	Sawcut, Remove and Dispose of Existing Concrete Street/Driveway Pavement, complete, per unit _____ _____Dollars & _____Cents	$_____	$_____
6	2,000	S.Y.	Sawcut, Remove and Dispose of Existing Concrete Sidewalk Pavement, complete, per unit _____ _____Dollars & _____Cents	$_____	$_____
7	3,100	S.Y.	Sawcut, Remove and Dispose of Existing Asphalt Pavement, complete, per unit _____ _____Dollars & _____Cents	$_____	$_____

CITY OF HIGHLAND VILLAGE
HIGHLAND SHORES BLVD RECONSTRUCTION PROJECT
(Twin Cove Drive/Hillside Drive To 200' West of Lake Cove)

BASE BID SCHEDULE

Item No.	Est. Quantity	Unit	Description & Unit Price in Words	Unit Price in Figures	Extended Amount
8	15	L.F.	Sawcut, Remove and Dispose of Existing Concrete Curb and Gutter, complete, per unit _____ _____Dollars & _____Cents	$_____	$_____
9	1,200	S.F.	Remove and Dispose of Existing Brick Pavers, complete, per unit _____ _____Dollars & _____Cents	$_____	$_____
10	35	S.Y.	Remove and Dispose of Existing Cinder Block Trail Pavers, complete, per unit _____ _____Dollars & _____Cents	$_____	$_____
11	18	EA.	Remove and Dispose of Existing Crape Myrtle, complete, per unit _____ _____Dollars & _____Cents	$_____	$_____
12	24	EA.	Remove and Dispose of Existing Trees (Over 6" dia.), complete, per unit _____ _____Dollars & _____Cents	$_____	$_____
13	350	L.F.	Remove and Dispose of Existing CPP (Corrugated Plastic Pipe), complete, per unit _____ _____Dollars & _____Cents	$_____	$_____
14	50	L.F.	Remove and Dispose of Existing CMP, complete, per unit _____ _____Dollars & _____Cents	$_____	$_____
15	140	L.F.	Remove and Dispose of Existing RCP, complete, per unit _____ _____Dollars & _____Cents	$_____	$_____

CITY OF HIGHLAND VILLAGE
HIGHLAND SHORES BLVD RECONSTRUCTION PROJECT
(Twin Cove Drive/Hillside Drive To 200' West of Lake Cove)

BASE BID SCHEDULE

Item No.	Est. Quantity	Unit	Description & Unit Price in Words	Unit Price in Figures	Extended Amount
16	8	EA.	Remove and Dispose of Existing Headwall, complete, per unit _____ _____Dollars & _____Cents	$_____	$_____
17	30	S.Y.	Remove and Dispose of Existing Concrete Riprap, complete, per unit _____ _____Dollars & _____Cents	$_____	$_____
18	2	EA.	Remove and Dispose of Existing Curb Inlet, complete, per unit _____ _____Dollars & _____Cents	$_____	$_____
19	4	EA.	Remove and Dispose of Existing Grate Inlet, complete, per unit _____ _____Dollars & _____Cents	$_____	$_____
20	110	L.F.	Remove and Dispose of Existing Guard Rail, including post, rail, etc., complete, per unit _____ _____Dollars & _____Cents	$_____	$_____
21	1	L.S.	Remove Existing Enhanced LED Crosswalk Signage, including crosswalk pole, foundation, ped. button, cabinet, and all appurtenances, complete, per unit _____ _____Dollars & _____Cents	$_____	$_____
22	39	EA.	Remove Existing Road Sign, Foundation, Post, and Panel, and return sign to City, complete, per unit _____ _____Dollars & _____Cents	$_____	$_____

CITY OF HIGHLAND VILLAGE
HIGHLAND SHORES BLVD RECONSTRUCTION PROJECT
(Twin Cove Drive/Hillside Drive To 200' West of Lake Cove)

BASE BID SCHEDULE

Item No.	Est. Quantity	Unit	Description & Unit Price in Words	Unit Price in Figures	Extended Amount
23	3	EA.	Remove and Dispose of Existing Upright Reflectors, complete, per unit _____ _____Dollars & _____Cents	$_____	$_____
24	650	L.F.	Remove and Dispose of Existing Free Standing Stone Wall, including foundation, stones, etc., complete, per unit _____ _____Dollars & _____Cents	$_____	$_____
25	50	L.F.	Remove and Dispose of Existing Retaining Sack Wall, including foundations, etc., complete, per unit _____ _____Dollars & _____Cents	$_____	$_____
26	40	L.F.	Remove and Dispose of Existing Landscape Edger, complete, per unit _____ _____Dollars & _____Cents	$_____	$_____
27	25	L.F.	Remove and Dispose of Existing Landscape Stone Wall, complete, per unit _____ _____Dollars & _____Cents	$_____	$_____
28	78	EA.	Remove and Relocated Existing Irrigation Valve, complete in place, per unit _____ _____Dollars & _____Cents	$_____	$_____
29	6	EA.	Remove Relocated Fire Hydrant, including storage, complete in place, per unit _____ _____Dollars & _____Cents	$_____	$_____
30	2	EA.	Remove and Relocated Existing Water Meter, including installation, complete in place, per unit _____ _____Dollars & _____Cents	$_____	$_____

CITY OF HIGHLAND VILLAGE
HIGHLAND SHORES BLVD RECONSTRUCTION PROJECT
(Twin Cove Drive/Hillside Drive To 200' West of Lake Cove)

BASE BID SCHEDULE

Item No.	Est. Quantity	Unit	Description & Unit Price in Words	Unit Price in Figures	Extended Amount
31	4	EA.	Remove and Relocated Existing Underground Utility Sign, including installation, complete in place, per unit _____ _____Dollars & _____Cents	$_____	$_____
			SCHEDULE "A" TOTAL:	$_____	
SCHEDULE 'B' - PAVING					
32	7,525	C.Y.	Unclassified Street Excavation, including hauling, placement and compaction at other locations on site, and removal of any excess material, complete per unit _____ _____Dollars & _____Cents	$_____	$_____
33	150	C.Y.	Borrow, including hauling, placement and compaction, complete in place, per unit _____ _____Dollars & _____Cents	$_____	$_____
34	24,500	S.Y.	Furnish and Place 8" Thick (4000 PSI) Reinforced Concrete Street Pavement with 6" Curb, complete in place, per unit _____ _____Dollars & _____Cents	$_____	$_____
35	30	S.Y.	Furnish and Place 6" Thick (4000 PSI) Reinforced Concrete Driveways, complete in place, per unit _____ _____Dollars & _____Cents	$_____	$_____
36	700	S.Y.	Furnish and Place 4" Thick (3000 PSI) Reinforced Stamped and Colored Concrete Median Pavement, complete in place, per unit _____ _____Dollars & _____Cents	$_____	$_____

CITY OF HIGHLAND VILLAGE
HIGHLAND SHORES BLVD RECONSTRUCTION PROJECT
(Twin Cove Drive/Hillside Drive To 200' West of Lake Cove)

BASE BID SCHEDULE

Item No.	Est. Quantity	Unit	Description & Unit Price in Words	Unit Price in Figures	Extended Amount
37	820	S.Y.	Furnish and Place 6" Thick (3000 PSI) Reinforced Concrete Sidewalk Pavement, complete in place, per unit _____ _____Dollars & _____Cents	$_____	$_____
38	60	S.Y.	Furnish and Place 5" Thick (3000 PSI) Reinforced Concrete Sidewalk Pavement, complete in place, per unit _____ _____Dollars & _____Cents	$_____	$_____
39	3,800	S.Y.	Furnish and Place 4" Thick (3000 PSI) Reinforced Concrete Sidewalk Pavement, complete in place, per unit _____ _____Dollars & _____Cents	$_____	$_____
40	40	S.Y.	Furnish and Place 6" Thick (3000 PSI) Reinforced Concrete Flume Pavement, complete in place, per unit _____ _____Dollars & _____Cents	$_____	$_____
41	90	L.F.	Construct Asphalt Street Header, complete in place, per unit _____ _____Dollars & _____Cents	$_____	$_____
42	425	L.F.	Furnish and Place 12" Tall Sidewalk Curb, complete in place, per unit _____ _____Dollars & _____Cents	$_____	$_____
43	125	L.F.	Furnish and Place 6" Tall Sidewalk Curb, complete in place, per unit _____ _____Dollars & _____Cents	$_____	$_____
44	1,100	L.F.	Furnish and Place Sidewalk Toe Wall, complete in place, per unit _____ _____Dollars & _____Cents	$_____	$_____

CITY OF HIGHLAND VILLAGE
HIGHLAND SHORES BLVD RECONSTRUCTION PROJECT
(Twin Cove Drive/Hillside Drive To 200' West of Lake Cove)

BASE BID SCHEDULE

Item No.	Est. Quantity	Unit	Description & Unit Price in Words	Unit Price in Figures	Extended Amount
45	100	L.F.	Furnish and Place Sidewalk Fill Wall, complete in place, per unit _____ _____Dollars & _____Cents	$_____	$_____
46	27,150	S.Y.	Construct 8" Thick Cement Treated Base, including placement, mixing, and compaction, complete in place, per unit _____ _____Dollars & _____Cents	$_____	$_____
47	490	Ton	Furnish Cement (@ 6% Cement by Dry Weight), complete in place, per unit _____ _____Dollars & _____Cents	$_____	$_____
48	100	S.Y.	Furnish and Place 8" Thick Aggregate Base (TxDOT Item 247) in leu of Cement Treated Base, complete in place including 8" Excavation, compaction and all appetences, per unit _____ _____Dollars & _____Cents	$_____	$_____
49	4	EA.	Furnish and Install Flume Crossing, complete in place, per unit _____ _____Dollars & _____Cents	$_____	$_____
50	32	EA.	Furnish and Place Barrier Free Ramp, including detectable warning surface, complete in place, per unit _____ _____Dollars & _____Cents	$_____	$_____
51	365	L.F.	Furnish and Install 42" Hand Rail, including foundation, complete in place, per unit _____ _____Dollars & _____Cents	$_____	$_____

BASE BID SCHEDULE

Item No.	Est. Quantity	Unit	Description & Unit Price in Words	Unit Price in Figures	Extended Amount
52	555	L.F.	Furnish and Install 8" SCH-80 PVC Sleeves, complete in place, per unit _____ _____Dollars & _____Cents	$_____	$_____
53	10	EA.	Adjust Existing Manhole Frame and Cover to Final Grade, complete, per unit _____ _____Dollars & _____Cents	$_____	$_____
54	22	EA.	Adjust Existing Water Valve to Final Grade, complete, per unit _____ _____Dollars & _____Cents	$_____	$_____
			SCHEDULE "B" TOTAL:	$_____	

SCHEDULE 'C' - DRAINAGE

55	1,100	L.F.	Trench Safety, complete, per unit _____ _____Dollars & _____Cents	$_____	$_____
56	10	EA.	Construct C.O.H. STD. 8' Curb Inlet, complete in place, per unit _____ _____Dollars & _____Cents	$_____	$_____
57	2	EA.	Construct C.O.H. STD. 2'x2' Wye Inlet with 2' Concrete Apron, complete in place, per unit _____ _____Dollars & _____Cents	$_____	$_____
58	1	EA.	Construct C.O.H. STD. 3'x3' Wye Inlet, complete in place, per unit _____ _____Dollars & _____Cents	$_____	$_____

CITY OF HIGHLAND VILLAGE
HIGHLAND SHORES BLVD RECONSTRUCTION PROJECT
(Twin Cove Drive/Hillside Drive To 200' West of Lake Cove)

BASE BID SCHEDULE

Item No.	Est. Quantity	Unit	Description & Unit Price in Words	Unit Price in Figures	Extended Amount
59	6	EA.	Construct C.O.H. STD. 3'x3' Wye Inlet with 2' Concrete Apron, complete in place, per unit _____ _____Dollars & _____Cents	$_____	$_____
60	4	EA.	Furnish and Install 8" Landscape Grate Inlet, complete in place, per unit _____ _____Dollars & _____Cents	$_____	$_____
61	1	EA.	Furnish and Install NDS FLO-WELL, including embedment, filter fabric, drain rock, etc., complete in place, per unit _____ _____Dollars & _____Cents	$_____	$_____
62	70	L.F.	Furnish and Install 18" RCP CL. IV, including embedment, complete in place, per unit _____ _____Dollars & _____Cents	$_____	$_____
63	130	L.F.	Furnish and Install 24" RCP CL. IV, including embedment, complete in place, per unit _____ _____Dollars & _____Cents	$_____	$_____
64	500	L.F.	Furnish and Install 18" RCP CL. III, including embedment, complete in place, per unit _____ _____Dollars & _____Cents	$_____	$_____
65	20	L.F.	Furnish and Install 21" RCP CL. III, including embedment, complete in place, per unit _____ _____Dollars & _____Cents	$_____	$_____

CITY OF HIGHLAND VILLAGE
HIGHLAND SHORES BLVD RECONSTRUCTION PROJECT
(Twin Cove Drive/Hillside Drive To 200' West of Lake Cove)

BASE BID SCHEDULE

Item No.	Est. Quantity	Unit	Description & Unit Price in Words	Unit Price in Figures	Extended Amount
66	110	L.F.	Furnish and Install 24" RCP CL. III, including embedment, complete in place, per unit _____ _____Dollars & _____Cents	$_____	$_____
67	45	L.F.	Furnish and Install 8" HDPE, including embedment, complete in place, per unit _____ _____Dollars & _____Cents	$_____	$_____
68	25	L.F.	Furnish and Install 15" HDPE, including embedment, complete in place, per unit _____ _____Dollars & _____Cents	$_____	$_____
69	5	L.F.	Furnish and Install 6" PVC SDR 35, including embedment, complete in place, per unit _____ _____Dollars & _____Cents	$_____	$_____
70	45	L.F.	Furnish and Install 8" PVC SDR 35, including embedment, complete in place, per unit _____ _____Dollars & _____Cents	$_____	$_____
71	170	L.F.	Furnish and Install 8" Perforated PVC SDR 35, including embedment, filter fabric, drain rock, etc., complete in place, per unit _____ _____Dollars & _____Cents	$_____	$_____
72	16	EA.	Furnish and Install Concrete Collar, complete in place, per unit _____ _____Dollars & _____Cents	$_____	$_____

CITY OF HIGHLAND VILLAGE
HIGHLAND SHORES BLVD RECONSTRUCTION PROJECT
(Twin Cove Drive/Hillside Drive To 200' West of Lake Cove)

BASE BID SCHEDULE

Item No.	Est. Quantity	Unit	Description & Unit Price in Words	Unit Price in Figures	Extended Amount
73	1	EA.	Furnish and Install 8" HDPE to 36" RCP Concrete Collar, complete in place, per unit _____ _____Dollars & _____Cents	$_____	$_____
74	4	EA.	Furnish and Install Wye Connection, complete in place, per unit _____ _____Dollars & _____Cents	$_____	$_____
75	1	EA.	Furnish and Install TxDOT 2-15" PSET (@ 7.5 degree Skew), complete in place, per unit _____ _____Dollars & _____Cents	$_____	$_____
76	6	EA.	Furnish and Install TxDOT 18" PSET, complete in place, per unit _____ _____Dollars & _____Cents	$_____	$_____
77	1	EA.	Furnish and Install TxDOT 21" PSET, complete in place, per unit _____ _____Dollars & _____Cents	$_____	$_____
78	3	EA.	Furnish and Install TxDOT 24" PSET, complete in place, per unit _____ _____Dollars & _____Cents	$_____	$_____
79	2	EA.	Furnish and Install 18" RCP Plug, complete in place, per unit _____ _____Dollars & _____Cents	$_____	$_____
80	1	EA.	Furnish and Install 8" PVC 22.5 Degree Bend, complete in place, per unit _____ _____Dollars & _____Cents	$_____	$_____

CITY OF HIGHLAND VILLAGE
HIGHLAND SHORES BLVD RECONSTRUCTION PROJECT
(Twin Cove Drive/Hillside Drive To 200' West of Lake Cove)

BASE BID SCHEDULE

Item No.	Est. Quantity	Unit	Description & Unit Price in Words	Unit Price in Figures	Extended Amount
81	4	EA.	Furnish and Install 18" RCP 30 Degree Bend, complete in place, per unit _____ _____Dollars & _____Cents	$_____	$_____
82	1	EA.	Furnish and Install 18" RCP 60 Degree Bend, complete in place, per unit _____ _____Dollars & _____Cents	$_____	$_____
83	10	L.F.	Furnish and Install TxDOT Extended Curb on Existing Headwall, complete in place, per unit _____ _____Dollars & _____Cents	$_____	$_____
84	1	EA.	Connect to Existing Wye Inlet, complete in place, per unit _____ _____Dollars & _____Cents	$_____	$_____
85	2	EA.	Connect to Existing Curb Inlet, complete in place, per unit _____ _____Dollars & _____Cents	$_____	$_____
86	20	S.Y.	Construct 12" Grouted Rip Rap with Toewall, complete in place, per unit _____ _____Dollars & _____Cents	$_____	$_____
87	160	S.Y.	Construct 18" Grouted Rip Rap with Toewall, complete in place, per unit _____ _____Dollars & _____Cents	$_____	$_____
88	1,825	L.F.	Grade-to-Drain Proposed Swale, complete in place, per unit _____ _____Dollars & _____Cents	$_____	$_____

SCHEDULE "C" TOTAL: $_____

CITY OF HIGHLAND VILLAGE
HIGHLAND SHORES BLVD RECONSTRUCTION PROJECT
(Twin Cove Drive/Hillside Drive To 200' West of Lake Cove)

BASE BID SCHEDULE

Item No.	Est. Quantity	Unit	Description & Unit Price in Words	Unit Price in Figures	Extended Amount
SCHEDULE 'D' - WATER					
89	1	L.S.	16" Water Line Lowering, including all appurtenances, complete in place, per unit _____ _____Dollars & _____Cents	$_____	$_____
90	210	L.F.	Trench Safety, complete, per unit _____ _____Dollars & _____Cents	$_____	$_____
91	2	EA.	Cut and Plug 16" Water Line, complete in place, per unit _____ _____Dollars & _____Cents	$_____	$_____
92	3	EA.	Close Existing Valve and Remove Stack, complete, per unit _____ _____Dollars & _____Cents	$_____	$_____
93	3	EA.	Connect to Existing 6" Water Line at Existing Valve Location and Install Relocated Fire Hydrant, complete in place, per unit _____ _____Dollars & _____Cents	$_____	$_____
94	1	EA.	Cut Out and Remove Existing 16" Water Line to Install 16" 45 Degree Bend, complete in place, per unit _____ _____Dollars & _____Cents	$_____	$_____
95	1	EA.	Cut Out and Remove Existing 16" Water Line to Connect 16" Water Line, complete in place, per unit _____ _____Dollars & _____Cents	$_____	$_____

CITY OF HIGHLAND VILLAGE
HIGHLAND SHORES BLVD RECONSTRUCTION PROJECT
(Twin Cove Drive/Hillside Drive To 200' West of Lake Cove)

BASE BID SCHEDULE

Item No.	Est. Quantity	Unit	Description & Unit Price in Words	Unit Price in Figures	Extended Amount
96	3	EA.	Cut Out and Remove Existing 16" Water Line to Install 16"x6" Tee, 6" Valve, and Relocated Fire Hydrant, complete in place, per unit _____ _____Dollars & _____Cents	$_____	$_____
97	45	L.F.	Furnish and Install 6" AWWA C900 (DR-18) PVC with B-1 Embedment, complete in place, per unit _____ _____Dollars & _____Cents	$_____	$_____
98	140	L.F.	Furnish and Install 16" AWWA C905 (DR-18) PVC with B-1 Embedment, complete in place, per unit _____ _____Dollars & _____Cents	$_____	$_____
99	60	L.F.	Furnish and Install 16" AWWA C905 (DR-18) PVC with G Embedment, complete in place, per unit _____ _____Dollars & _____Cents	$_____	$_____
100	1	EA.	Furnish and Install 16" 45 Degree Bend, complete in place, per unit _____ _____Dollars & _____Cents	$_____	$_____
			SCHEDULE "D" TOTAL:		$_____

SCHEDULE 'E' - STRIPING

101	1	L.S.	Remove Existing Pavement Markings and Striping, complete, per unit _____ _____Dollars & _____Cents	$_____	$_____

CITY OF HIGHLAND VILLAGE
HIGHLAND SHORES BLVD RECONSTRUCTION PROJECT
(Twin Cove Drive/Hillside Drive To 200' West of Lake Cove)

BASE BID SCHEDULE

Item No.	Est. Quantity	Unit	Description & Unit Price in Words	Unit Price in Figures	Extended Amount
102	520	L.F.	Furnish and Place 4" White Thermoplastic Solid Stripe, complete in place, per unit _____ _____Dollars & _____Cents	$_____	$_____
103	300	L.F.	Furnish and Place 4" Yellow Solid Thermoplastic Stripe, complete in place, per unit _____ _____Dollars & _____Cents	$_____	$_____
104	120	L.F.	Furnish and Place 4" Double Yellow Solid Thermoplastic Stripe, complete in place, per unit _____ _____Dollars & _____Cents	$_____	$_____
105	740	L.F.	Furnish and Place 18" White Thermoplastic Stop Bar, complete in place, per unit _____ _____Dollars & _____Cents	$_____	$_____
106	210	L.F.	Furnish and Place 4" White Thermoplastic Dash Stripe, complete in place, per unit _____ _____Dollars & _____Cents	$_____	$_____
107	150	L.F.	Furnish and Place 4" White Thermoplastic Broken Lane Line Stripe, complete in place, per unit _____ _____Dollars & _____Cents	$_____	$_____
108	320	L.F.	Furnish and Place 4" Yellow Thermoplastic Dash Stripe, complete in place, per unit _____ _____Dollars & _____Cents	$_____	$_____
109	160	L.F.	Furnish and Place 4" Double Yellow Thermoplastic Dash Stripe, complete in place, per unit _____ _____Dollars & _____Cents	$_____	$_____

CITY OF HIGHLAND VILLAGE
HIGHLAND SHORES BLVD RECONSTRUCTION PROJECT
(Twin Cove Drive/Hillside Drive To 200' West of Lake Cove)

BASE BID SCHEDULE

Item No.	Est. Quantity	Unit	Description & Unit Price in Words	Unit Price in Figures	Extended Amount
110	1,930	L.F.	Furnish and Place 8" White Solid Thermoplastic Stripe, complete in place, per unit _____ _____Dollars & _____Cents	$_____	$_____
111	11,450	L.F.	Furnish and Place Bike Lane Line (Stripe/Button), complete in place, per unit _____ _____Dollars & _____Cents	$_____	$_____
112	250	L.F.	Furnish and Place Broken Bike Lane Line, complete in place, per unit _____ _____Dollars & _____Cents	$_____	$_____
113	25	L.F.	Furnish and Place 12" White Solid Thermoplastic Diagonal Stripe, complete in place, per unit _____ _____Dollars & _____Cents	$_____	$_____
114	130	L.F.	Furnish and Place 12" Yellow Solid Thermoplastic Diagonal Stripe, complete in place, per unit _____ _____Dollars & _____Cents	$_____	$_____
115	3,000	S.F.	Furnish and Place Green Thermoplastic Bike Lane, complete in place, per unit _____ _____Dollars & _____Cents	$_____	$_____
116	1,370	L.F.	Furnish and Place 12" White Solid Thermoplastic Crosswalk Stripe, complete in place, per unit _____ _____Dollars & _____Cents	$_____	$_____
117	38	EA.	Furnish and Install Pavement Directional Marking, complete in place, per unit _____ _____Dollars & _____Cents	$_____	$_____

BASE BID SCHEDULE

Item No.	Est. Quantity	Unit	Description & Unit Price in Words	Unit Price in Figures	Extended Amount
118	48	EA.	Furnish and Install Bicycle Pavement Marker W/Directional Marker, complete in place, per unit _____ _____Dollars & _____Cents	$_____	$_____
119	47	EA.	Furnish and Install Traffic Sign, including foundation, complete in place, per unit _____ _____Dollars & _____Cents	$_____	$_____
120	2	EA.	Furnish and Install Radar Sign, including foundation, complete in place, per unit _____ _____Dollars & _____Cents	$_____	$_____
121	1	L.S.	Furnish and Install LED Pedestrian warning system, including signs, posts, solar panels, sensors and all appurtenances, complete in place, per unit _____ _____Dollars & _____Cents	$_____	$_____
			SCHEDULE "E" TOTAL:	$_____	

SCHEDULE 'F' - MISCELLANEOUS

122	1	L.S.	Furnish and Construct Block Retaining Wall, including all appurtenances, complete in place, per unit _____ _____Dollars & _____Cents	$_____	$_____
123	10,000	S.Y.	Furnish and Place Hydromulch, including watering and fertilizer until established, complete in place, per unit _____ _____Dollars & _____Cents	$_____	$_____

CITY OF HIGHLAND VILLAGE
HIGHLAND SHORES BLVD RECONSTRUCTION PROJECT
(Twin Cove Drive/Hillside Drive To 200' West of Lake Cove)

BASE BID SCHEDULE

Item No.	Est. Quantity	Unit	Description & Unit Price in Words	Unit Price in Figures	Extended Amount
124	15,000	S.Y.	Furnish and Place Block Sodding, including 4" topsoil, watering and fertilizer until established, complete in place, per unit _____ _____Dollars & _____Cents	$_____	$_____
125	1	L.S.	Irrigation Repairs Allowance, including all appurtenances and incidentals, complete in place, per unit Seventy Five Thousand Dollars & No Cents	$75,000.00	$75,000.00
126	1	L.S.	Box Culvert Spalling Repairs, complete, per unit _____ _____Dollars & _____Cents	$_____	$_____
127	1	L.S.	Repair Existing Stone Masonry Free Standing Wall, complete, in place, per unit _____ _____Dollars & _____Cents	$_____	$_____

SCHEDULE "F" TOTAL: $_____

CITY OF HIGHLAND VILLAGE
HIGHLAND SHORES BLVD RECONSTRUCTION PROJECT
(Twin Cove Drive/Hillside Drive To 200' West of Lake Cove)

BASE BID SCHEDULE

SCHEDULE "A" TOTAL: $_____

SCHEDULE "B" TOTAL: $_____

SCHEDULE "C" TOTAL: $_____

SCHEDULE "D" TOTAL: $_____

SCHEDULE "E" TOTAL: $_____

SCHEDULE "F" TOTAL: $_____

TOTAL AMOUNT BID, ITEMS 1 THROUGH 127 INCLUSIVE: $_____

TOTAL AMOUNT BID, ITEMS 1 THROUGH 127 INCLUSIVE (IN WORDS):

_____

_____

_____

BREAKDOWN OF TOTAL AMOUNT BID IN MATERIAL AND LABOR:

TOTAL MATERIAL AMOUNT BID, ITEMS 1 THROUGH 127, INCLUSIVE: $_____

TOTAL LABOR AMOUNT BID, ITEMS 1 THROUGH 127, INCLUSIVE: $_____

CITY OF HIGHLAND VILLAGE
HIGHLAND SHORES BLVD RECONSTRUCTION PROJECT
(Twin Cove Drive/Hillside Drive To 200' West of Lake Cove)

ADD ALTERNATE 1 BID SCHEDULE

Items A1-1 through A1-17 represent an Add Alternate 1 Bid
The Owner reserves the right to select this Add Alternate Bid at the Owner's discretion.

Item No.	Est. Quantity	Unit	Description & Unit Price in Words	Unit Price in Figures	Extended Amount
A1-1	60	S.Y.	Sawcut, Remove and Dispose of Existing Concrete Sidewalk Pavement, complete, per unit _____ _____Dollars & _____Cents	$_____	$_____
A1-2	30	S.Y.	Sawcut, Remove and Dispose of Existing Asphalt Pavement, complete, per unit _____ _____Dollars & _____Cents	$_____	$_____
A1-3	2	EA.	Remove and Dispose Bollards, complete, per unit _____ _____Dollars & _____Cents	$_____	$_____
A1-4	35	L.F.	Remove and Dispose Wood Fence, complete, per unit _____ _____Dollars & _____Cents	$_____	$_____
A1-5	1	EA.	Remove Existing Road Sign, Foundation and Post, and return sign to City, complete, per unit _____ _____Dollars & _____Cents	$_____	$_____
A1-6	45	S.Y.	Furnish and Place 8" Thick (4000 PSI) Reinforced Concrete Street Pavement with 6" Curb, complete in place, per unit _____ _____Dollars & _____Cents	$_____	$_____
A1-7	15	S.Y.	Furnish and Place 6" Thick (4000 PSI) Reinforced Concrete Driveways, complete in place, per unit _____ _____Dollars & _____Cents	$_____	$_____

CITY OF HIGHLAND VILLAGE
HIGHLAND SHORES BLVD RECONSTRUCTION PROJECT
(Twin Cove Drive/Hillside Drive To 200' West of Lake Cove)

ADD ALTERNATE 1 BID SCHEDULE

Items A1-1 through A1-17 represent an Add Alternate 1 Bid
The Owner reserves the right to select this Add Alternate Bid at the Owner's discretion.

Item No.	Est. Quantity	Unit	Description & Unit Price in Words	Unit Price in Figures	Extended Amount
A1-8	180	S.Y.	Furnish and Place 2" Type 'D' HMAC Surface Course, complete in place, per unit _____ _____Dollars & _____Cents	$_____	$_____
A1-9	180	S.Y.	Furnish and Place 2" Type 'B' HMAC Binder Course, complete in place, per unit _____ _____Dollars & _____Cents	$_____	$_____
A1-10	33	L.F.	Furnish and Place 6" Tall integral Curb, complete in place, per unit _____ _____Dollars & _____Cents	$_____	$_____
A1-11	20	GAL.	Furnish and Place Tack Coat (@ 0.05 Gal/S.Y.), complete in place, per unit _____ _____Dollars & _____Cents	$_____	$_____
A1-12	55	GAL.	Furnish and Place Prime Coat (@ 0.30 Gal/S.Y.), complete in place, per unit _____ _____Dollars & _____Cents	$_____	$_____
A1-13	270	S.Y.	Construct 8" Thick Cement Treated Base, including placement, mixing, and compaction, complete in place, per unit _____ _____Dollars & _____Cents	$_____	$_____
A1-14	5	Ton	Furnish Cement (@ 6% Cement by Dry Weight), complete in place, per unit _____ _____Dollars & _____Cents	$_____	$_____

CITY OF HIGHLAND VILLAGE
HIGHLAND SHORES BLVD RECONSTRUCTION PROJECT
(Twin Cove Drive/Hillside Drive To 200' West of Lake Cove)

ADD ALTERNATE 1 BID SCHEDULE

Items A1-1 through A1-17 represent an Add Alternate 1 Bid
The Owner reserves the right to select this Add Alternate Bid at the Owner's discretion.

Item No.	Est. Quantity	Unit	Description & Unit Price in Words	Unit Price in Figures	Extended Amount
A1-15	15	L.F.	Construct Asphalt Street Header, complete in place, per unit _____ _____Dollars & _____Cents	$_____	$_____
A1-16	1	EA.	Furnish and Install Traffic Sign, including foundation, complete in place, per unit _____ _____Dollars & _____Cents	$_____	$_____
A1-17	100	L.F.	Furnish and Place 4" White Thermoplastic Solid Stripe, complete in place, per unit _____ _____Dollars & _____Cents	$_____	$_____

ADD ALTERANTE 1 TOTAL: $_____

CITY OF HIGHLAND VILLAGE
HIGHLAND SHORES BLVD RECONSTRUCTION PROJECT
(Twin Cove Drive/Hillside Drive To 200' West of Lake Cove)

ADD ALTERNATE 1 BID SCHEDULE

TOTAL AMOUNT BID, ITEMS A1-1 THROUGH A1-17 INCLUSIVE: $_____

TOTAL AMOUNT BID, ITEMS A1-1 THROUGH A1-17 INCLUSIVE (IN WORDS):

_____

_____

_____

BREAKDOWN OF TOTAL AMOUNT BID IN MATERIAL AND LABOR:

TOTAL MATERIAL AMOUNT BID, ITEMS A1-1 THROUGH A1-17, INCLUSIVE: $_____

TOTAL LABOR AMOUNT BID, ITEMS A1-1 THROUGH A1-17, INCLUSIVE: $_____

The Owner reserves the right to select this Add Alternate Bid at the Owner's discretion.

CITY OF HIGHLAND VILLAGE
HIGHLAND SHORES BLVD RECONSTRUCTION PROJECT
(Twin Cove Drive/Hillside Drive To 200' West of Lake Cove)

ADD ALTERNATE 2 BID SCHEDULE

Items A2-1 through A2-9 represent an Add Alternate 2 Bid
The Owner reserves the right to select this Add Alternate Bid at the Owner's discretion.

Item No.	Est. Quantity	Unit	Description & Unit Price in Words	Unit Price in Figures	Extended Amount
A2-1	640	L.F.	Furnish and Place 4" White Thermoplastic Solid Stripe, complete in place, per unit _____ _____Dollars & _____Cents	$_____	$_____
A2-2	35	L.F.	Furnish and Place 12" White Thermoplastic Stop Bar, complete in place, per unit _____ _____Dollars & _____Cents	$_____	$_____
A2-3	240	L.F.	Furnish and Place 8" White Solid Thermoplastic Stripe, complete in place, per unit _____ _____Dollars & _____Cents	$_____	$_____
A2-4	20	L.F.	Furnish and Place 12" White Solid Thermoplastic Diagonal Stripe, complete in place, per unit _____ _____Dollars & _____Cents	$_____	$_____
A2-5	75	L.F.	Furnish and Place 12" Yellow Solid Thermoplastic Diagonal Stripe, complete in place, per unit _____ _____Dollars & _____Cents	$_____	$_____
A2-6	80	L.F.	Furnish and Place 12" White Solid Thermoplastic Crosswalk Stripe, complete in place, per unit _____ _____Dollars & _____Cents	$_____	$_____
A2-7	8	EA.	Furnish and Install Pavement Directional Marking, complete in place, per unit _____ _____Dollars & _____Cents	$_____	$_____

CITY OF HIGHLAND VILLAGE
HIGHLAND SHORES BLVD RECONSTRUCTION PROJECT
(Twin Cove Drive/Hillside Drive To 200' West of Lake Cove)

ADD ALTERNATE 2 BID SCHEDULE

Items A2-1 through A2-9 represent an Add Alternate 2 Bid
The Owner reserves the right to select this Add Alternate Bid at the Owner's discretion.

Item No.	Est. Quantity	Unit	Description & Unit Price in Words	Unit Price in Figures	Extended Amount
A2-8	6	EA.	Furnish and Install Pavement Words, complete in place, per unit _____ _____Dollars & _____Cents	$_____	$_____
A2-9	450	L.F.	Furnish and Place 4" Double Yellow Thermoplastic Solid Stripe, complete in place, per unit _____ _____Dollars & _____Cents	$_____	$_____

ADD ALTERANTE 2 TOTAL: $_____

CITY OF HIGHLAND VILLAGE
HIGHLAND SHORES BLVD RECONSTRUCTION PROJECT
(Twin Cove Drive/Hillside Drive To 200' West of Lake Cove)

ADD ALTERNATE 2 BID SCHEDULE

TOTAL AMOUNT BID, ITEMS A2-1 THROUGH A2-9 INCLUSIVE: $_____

TOTAL AMOUNT BID, ITEMS A2-1 THROUGH A2-9 INCLUSIVE (IN WORDS):

_____

_____

_____

BREAKDOWN OF TOTAL AMOUNT BID IN MATERIAL AND LABOR:

TOTAL MATERIAL AMOUNT BID, ITEMS A2-1 THROUGH A2-9, INCLUSIVE: $_____

TOTAL LABOR AMOUNT BID, ITEMS A2-1 THROUGH A2-9, INCLUSIVE: $_____

The Owner reserves the right to select this Add Alternate Bid at the Owner's discretion.

CITY OF HIGHLAND VILLAGE
HIGHLAND SHORES BLVD RECONSTRUCTION PROJECT
(Twin Cove Drive/Hillside Drive To 200' West of Lake Cove)

ADD ALTERNATE 3 BID SCHEDULE

Items A3-1 through A3-2 represent an Add Alternate 3 Bid
The Owner reserves the right to select this Add Alternate Bid at the Owner's discretion.

Item No.	Est. Quantity	Unit	Description & Unit Price in Words	Unit Price in Figures	Extended Amount
A3-1	26	EA.	Furnish and Install Street Signs, complete in place, per unit _____ _____Dollars & _____Cents	$_____	$_____
A3-2	33	EA.	Furnish and Install Decorative Sign Post, including all appurtenances, complete in place, per unit _____ _____Dollars & _____Cents	$_____	$_____

ADD ALTERANTE 3 TOTAL: $_____

CITY OF HIGHLAND VILLAGE
HIGHLAND SHORES BLVD RECONSTRUCTION PROJECT
(Twin Cove Drive/Hillside Drive To 200' West of Lake Cove)

ADD ALTERNATE 3 BID SCHEDULE

TOTAL AMOUNT BID, ITEMS A3-1 THROUGH A3-2 INCLUSIVE: $_____

TOTAL AMOUNT BID, ITEMS A3-1 THROUGH A3-2 INCLUSIVE (IN WORDS):

_____

_____

_____

BREAKDOWN OF TOTAL AMOUNT BID IN MATERIAL AND LABOR:

TOTAL MATERIAL AMOUNT BID, ITEMS A3-1 THROUGH A3-2, INCLUSIVE: $_____

TOTAL LABOR AMOUNT BID, ITEMS A3-1 THROUGH A3-2, INCLUSIVE: $_____

The Owner reserves the right to select this Add Alternate Bid at the Owner's discretion.

CITY OF HIGHLAND VILLAGE
HIGHLAND SHORES BLVD RECONSTRUCTION PROJECT
(Twin Cove Drive/Hillside Drive To 200' West of Lake Cove)

ADD ALTERNATE 4 BID SCHEDULE

Items A4-1 represent an Add Alternate 4 Bid
The Owner reserves the right to select this Add Alternate Bid at the Owner's discretion.

Item No.	Est. Quantity	Unit	Description & Unit Price in Words	Unit Price in Figures	Extended Amount
A4-1	40	EA.	Furnish and Install Decorative Sign Post, including all appurtenances, complete in place, per unit _____ _____Dollars & _____Cents	$_____	$_____

ADD ALTERANTE 4 TOTAL: $_____

CITY OF HIGHLAND VILLAGE
HIGHLAND SHORES BLVD RECONSTRUCTION PROJECT
(Twin Cove Drive/Hillside Drive To 200' West of Lake Cove)

ADD ALTERNATE 4 BID SCHEDULE

TOTAL AMOUNT BID, ITEM A4-1 INCLUSIVE: $_____

TOTAL AMOUNT BID, ITEM A4-1 INCLUSIVE (IN WORDS):

_____

_____

_____

BREAKDOWN OF TOTAL AMOUNT BID IN MATERIAL AND LABOR:

TOTAL MATERIAL AMOUNT BID, ITEM A4-1 INCLUSIVE: $_____

TOTAL LABOR AMOUNT BID, ITEM A4-1 INCLUSIVE: $_____

The Owner reserves the right to select this Add Alternate Bid at the Owner's discretion.

CITY OF HIGHLAND VILLAGE
HIGHLAND SHORES BLVD RECONSTRUCTION PROJECT
(Twin Cove Drive/Hillside Drive To 200' West of Lake Cove)

ADD ALTERNATE 5 BID SCHEDULE

Items A5-1 through A5-3 represent an Add Alternate 5 Bid
The Owner reserves the right to select this Add Alternate Bid at the Owner's discretion.

Item No.	Est. Quantity	Unit	Description & Unit Price in Words	Unit Price in Figures	Extended Amount
A5-1	-1	L.S.	Furnish and Construct Block Retaining Wall, including all appurtenances, complete in place, per unit _____ _____Dollars & _____Cents	$_____	$_____
A5-2	-10	L.F.	Furnish and Install TxDOT Extended Curb on Existing Headwall, complete in place, per unit _____ _____Dollars & _____Cents	$_____	$_____
A5-3	1	L.S.	Furnish and Construct Reinforced Concrete Retaining Wall (TxDOT Type C), including all appurtenances, complete in place, per unit _____ _____Dollars & _____Cents	$_____	$_____

ADD ALTERANTE 5 TOTAL: $_____

CITY OF HIGHLAND VILLAGE
HIGHLAND SHORES BLVD RECONSTRUCTION PROJECT
(Twin Cove Drive/Hillside Drive To 200' West of Lake Cove)

ADD ALTERNATE 5 BID SCHEDULE

TOTAL AMOUNT BID, ITEMS A5-1 THROUGH A5-3 INCLUSIVE: $_____

TOTAL AMOUNT BID, ITEMS A5-1 THROUGH A5-3 INCLUSIVE (IN WORDS):

_____

_____


_____

BREAKDOWN OF TOTAL AMOUNT BID IN MATERIAL AND LABOR:

TOTAL MATERIAL AMOUNT BID, ITEMS A5-1 THROUGH A5-3, INCLUSIVE: $_____


TOTAL LABOR AMOUNT BID, ITEMS A5-1 THROUGH A5-3, INCLUSIVE: $_____

The Owner reserves the right to select this Add Alternate Bid at the Owner's discretion.

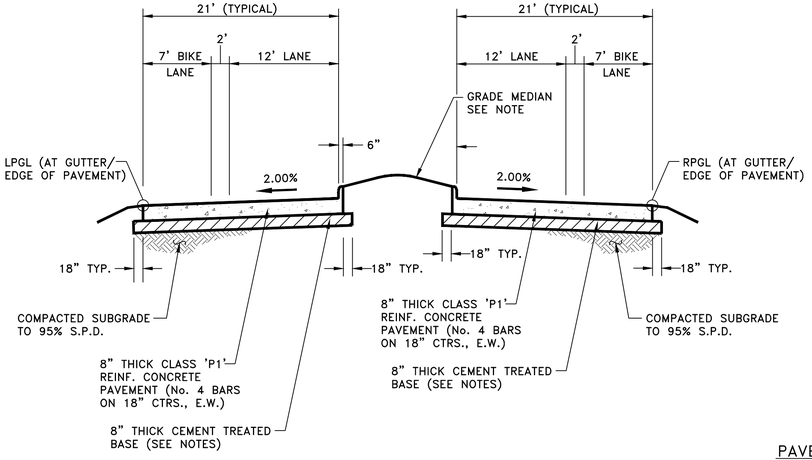


HIGHLAND SHORES BLVD PAVEMENT SECTION

NOT TO SCALE

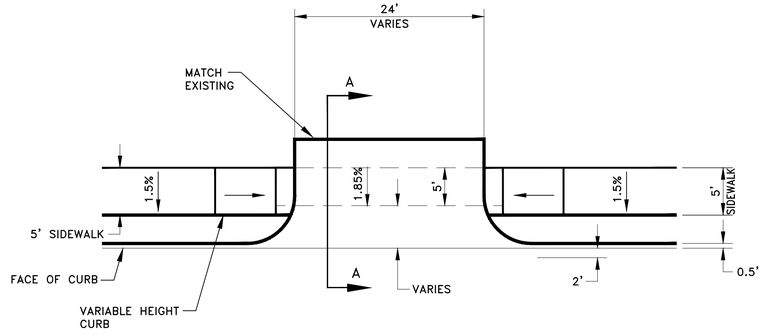

PLAN VIEW AT DRIVEWAYS

NOT TO SCALE

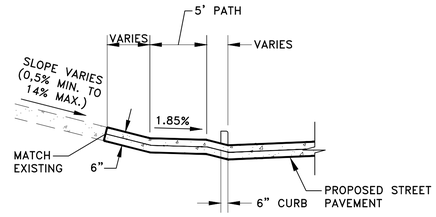


TYPICAL CROSS-SECTION A-A

NOT TO SCALE

PAVEMENT SECTION NOTES:

1. STREET PAVEMENT SHALL BE 8" THICK CLASS 'P1' (4,000 PSI) WITH No.4 BARS ON 18" CENTERS EACH WAY. BAR LAPS SHALL BE 30 DIAMETER. BAR CHAIRS OR APPROVED SUPPORTING DEVICE SHALL BE FURNISHED.
2. CEMENT TREATED BASE SHALL BE 6% CEMENT BY DRY WEIGHT MEASURE. CEMENT TREATED BASE SHALL BE 8" THICK AND CONFORMS TO TXDOT ITEM 275. CEMENT SHALL BE PLACED BY SLURRY METHOD.
3. AFTER CEMENT MIXING, THE SOIL/CEMENT MIXTURE SHALL BE COMPACTED TO A MINIMUM OF 95% OF STANDARD PROCTOR (ASTM D698) AND TO A MOISTURE CONTENT THAT IS AT OR ABOVE THE OPTIMUM MOISTURE.
4. ⚠1 IN LUE OF 8" CEMENT TREATED BASE CONTRACTOR MAY USE 8" THICK AGGREGATE BASE. AGGREGATE BASE SHALL BE TXDOT TYPE A OR TYPE D AND MEET TXDOT ITEM 247 GRADE 1-2. AGGREGATE BASE SHALL BE COMPACTED IN 4" TO 6" COMPACTED LIFTS TO A MINIMUM OF 95% OF THE MAXIMUM STANDARD PROCTOR (ASTM D698). ADDITIONAL EXCAVATION OF EXISTING EXCESS 8" MATERIAL SHALL BE SUBSIDIARY TO 8" THICK AGGREGATE BASE.
5. SUBGRADE SHALL BE COMPACTED TO A MINIMUM OF 95% OF STANDARD PROCTOR AT -2% TO +4% OPTIMUM MOISTURE. THERE IS NO SEPARATE PAY FOR THIS AND IT CONSIDERED SUBSIDIARY TO CEMENT BASE/AGGREGATE BASE.
6. ALL CURBS SHALL BE PLACED INTEGRAL WITH PAVEMENT AND SHALL MEET THE SAME COMPRESSIVE STRENGTH AS PAVEMENT. REINFORCEMENT SHALL BE No. 4 BARS.
7. FINAL MEDIAN SHALL BE SMOOTHLY GRADED AND MOUNDED TO A 6"-12" CROWN ABOVE THE TOP OF THE FINAL CURBS, OR AT A MINIMUM OF 2.0% UNLESS NOTED OTHERWISE. MEDIAN SHALL BE GRADED TO PROVIDE POSITIVE DRAINAGE, AND INCLUDE 4" OF TOPSOIL AND SOD.

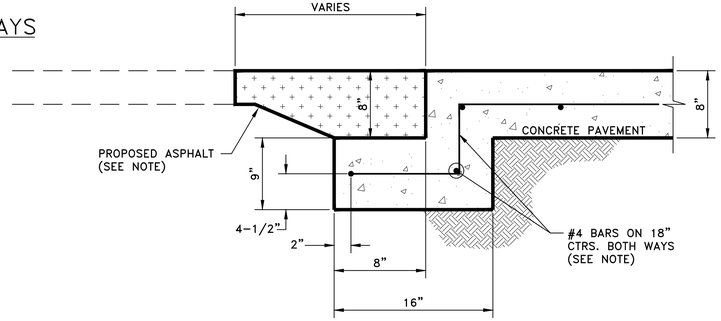



STREET HEADER FOR ASPHALT PAVEMENT

NOT TO SCALE

ASPHALT HEADER NOTES:

1. CONTRACTOR SHALL REMOVE AND REPLACE EXISTING ASPHALT AS REQUIRED TO CONSTRUCT THE ASPHALT HEADER. THERE IS NO SEPARATE PAY FOR 8" ASPHALT AND IT IS CONSIDERED SUBSIDIARY TO ASPHALT HEADER.
2. 8" REPLACEMENT ASPHALT SHALL:
   - 2" TYPE 'D' HMAC SURFACE COURSE
   - TACK COAT (@ 0.05 GAL/S.Y.)
   - 3" TYPE 'B' HMAC SURFACE COURSE
   - TACK COAT (@ 0.05 GAL/S.Y.)
   - 3" TYPE 'B' HMAC SURFACE COURSE
   - PRIME COAT (@ 0.30 GAL/S.Y.)
   - COMPACTED SUBGRADE TO 95% S.P.D.
3. CONTRACTOR SHALL GRADE REPLACEMENT ASPHALT TO ENSURE WATER DOES NOT POND.

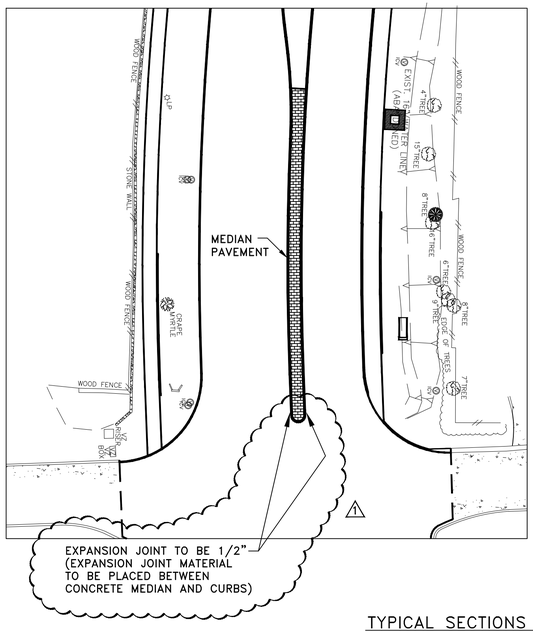
STONE WALL
WOOD FENCE
WOOD FENCE
CRAPE MYRTLE
WOOD FENCE
WOOD FENCE
STONE WALL
WOOD FENCE
WOOD FENCE
WOOD FENCE

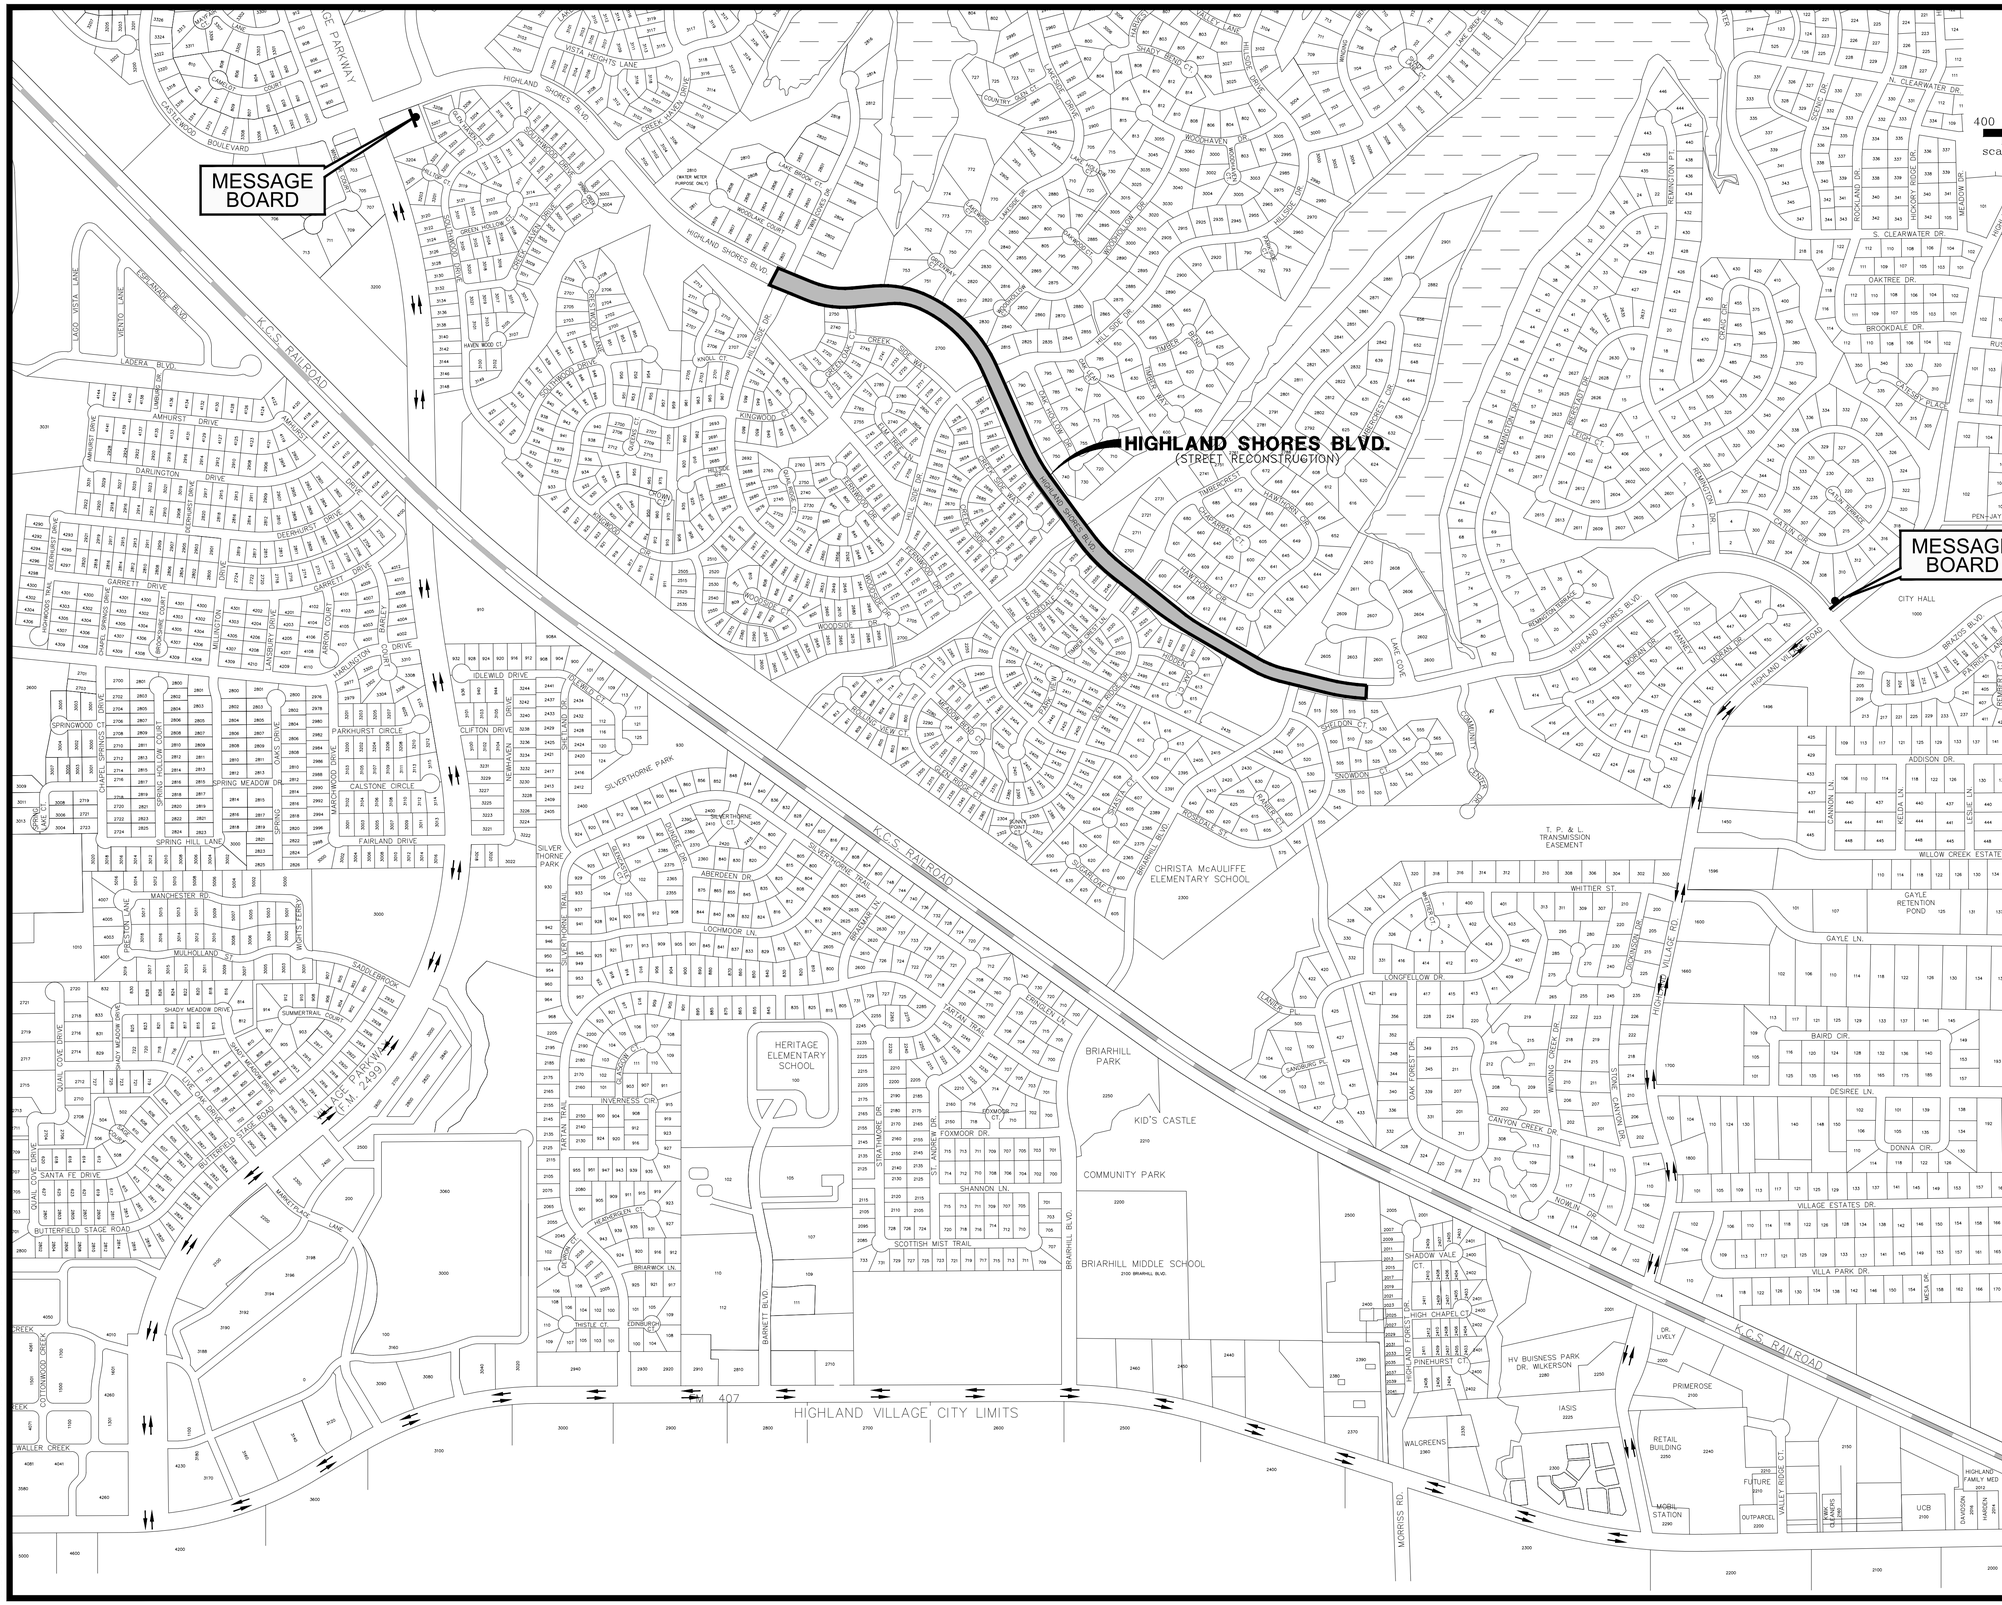

J:\23-2132 HIGHLAND SHORES REHAB\DRAWINGS DWG. NAME: 2132DETOUR

SCHAUMBURG & POLK, INC.
BEAUMONT I HOUSTON I RICHARDSON
KYLE I PORT ARTHUR I TERRELL I TYLER
2201 N. CENTRAL EXPRESSWAY, SUITE 205
Richardson, Texas 75080
(972) 864-8200 (T) (972) 864-8220 (F)
Firm Registration No. F-520

STATE OF TEXAS
JONATHAN D. WATKINS
130743
REGISTERED
PROFESSIONAL ENGINEER

CITY OF HIGHLAND VILLAGE

HIGHLAND SHORES BOULEVARD RECONSTRUCTION PROJECT

(FROM TWIN COVE DRIVE/HILLSIDE DRIVE TO 200'± WEST OF LAKE COVE)

DETOUR PLAN

NO.:	DATE:	REVISION:	REVIEWED:
7			
6			
5			
4			
3			
2			
1	11/11/26	DETOUR SIGNS REMOVED	JDW

SCALE:
1" = 400'

DATE:
SEPTEMBER 2026

DRAWN BY:
SPI

REVIEWED BY:
JDW

PROJECT NO:
23-2132


SHEET NO:
26

C/L SIDEWALK "A"

STATION	NORTHING(Y)	EASTING(X)
P.C. STA. 32+63.09	7081637.7683	2408491.5715
P.R.C. STA. 32+87.00	7081627.5984	2408513.1843
P.T. STA. 32+99.84	7081622.3176	2408524.8744
P.C. STA. 33+71.14	7081588.8559	2408587.8404
P.T. STA. 34+55.72	7081544.0385	2408659.4911
P.C. STA. 34+82.18	7081528.4659	2408680.8744
P.C.C. STA. 35+06.87	7081516.5413	2408702.4277
P.C.C. STA. 35+88.02	7081491.7920	2408779.6406

C/L SIDEWALK "A" CURVE DATA

NUMBER	RADIUS	DELTA ANGLE	ARC LENGTH	CHORD DIRECTION	CHORD LENGTH
C148	150.00'	09°08'01"	23.91'	S 64°48'02" E	23.89'
C149	100.00'	07°21'17"	12.84'	S 65°41'24" E	12.83'
C150	600.00'	08°04'37"	84.58'	S 57°58'27" E	84.51'
C151	99.50'	14°13'14"	24.70'	S 61°02'45" E	24.63'
C152	571.00'	08°08'34"	81.15'	S 72°13'39" E	81.08'
C153	30.00'	46°33'38"	24.38'	N 80°25'14" E	23.71'

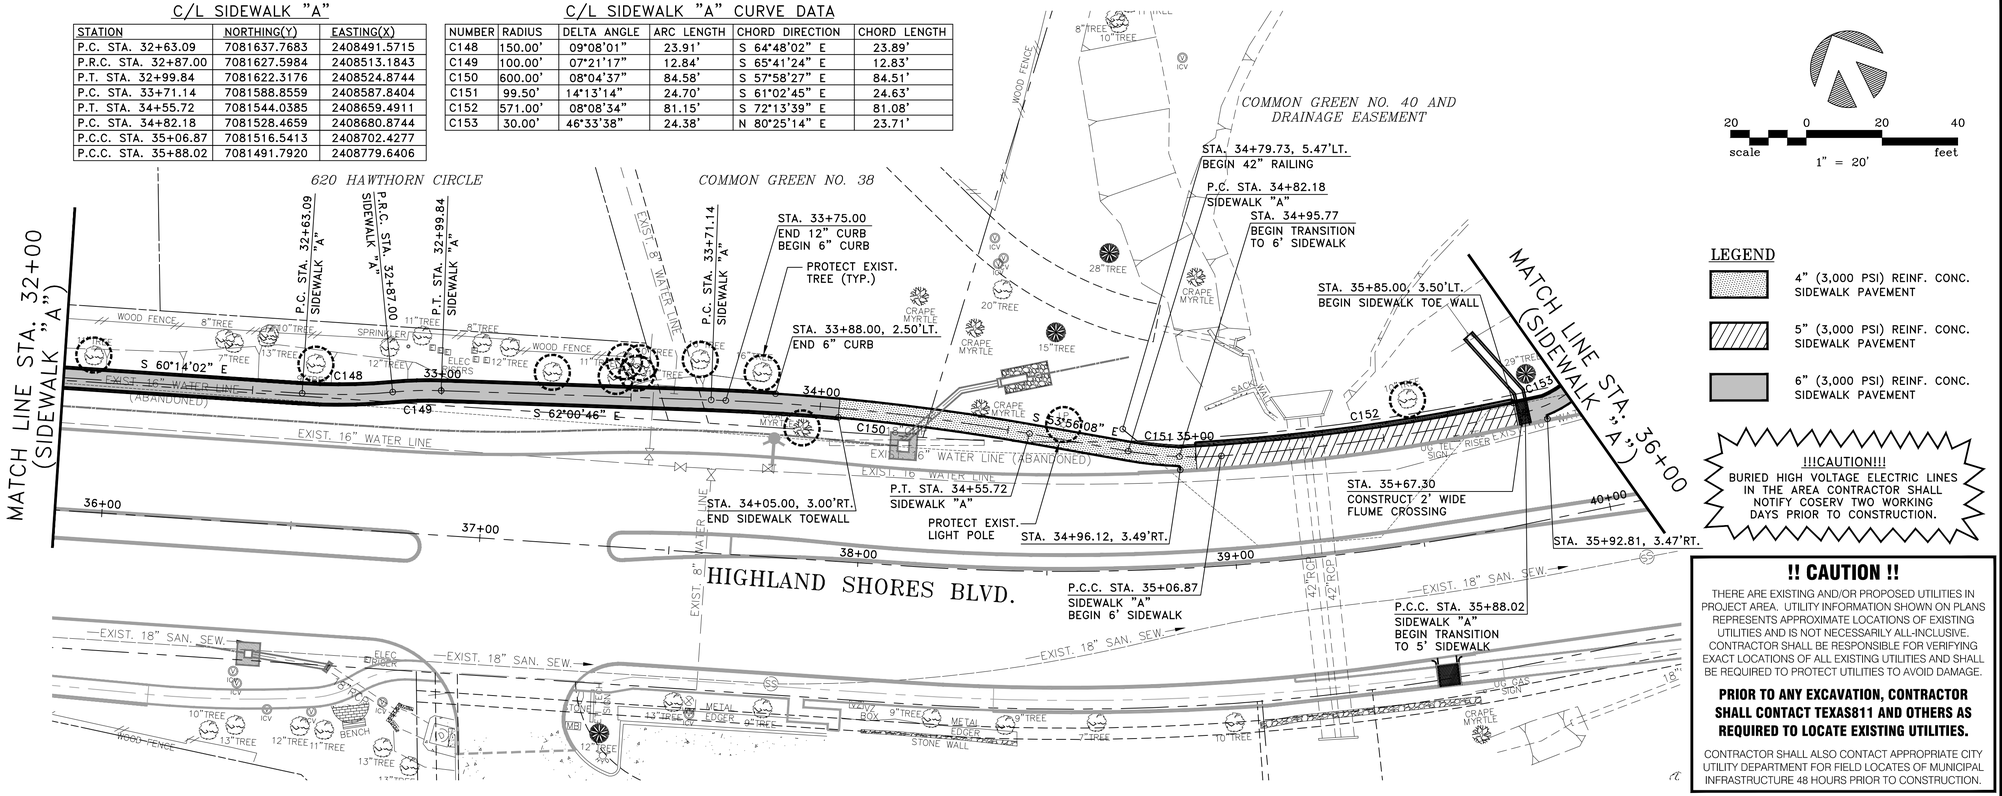


!! CAUTION !!

THERE ARE EXISTING AND/OR PROPOSED UTILITIES IN PROJECT AREA. UTILITY INFORMATION SHOWN ON PLANS REPRESENTS APPROXIMATE LOCATIONS OF EXISTING UTILITIES AND IS NOT NECESSARILY ALL-INCLUSIVE. CONTRACTOR SHALL BE RESPONSIBLE FOR VERIFYING EXACT LOCATIONS OF ALL EXISTING UTILITIES AND SHALL BE REQUIRED TO PROTECT UTILITIES TO AVOID DAMAGE.

PRIOR TO ANY EXCAVATION, CONTRACTOR SHALL CONTACT TEXAS811 AND OTHERS AS REQUIRED TO LOCATE EXISTING UTILITIES.

CONTRACTOR SHALL ALSO CONTACT APPROPRIATE CITY UTILITY DEPARTMENT FOR FIELD LOCATES OF MUNICIPAL INFRASTRUCTURE 48 HOURS PRIOR TO CONSTRUCTION.

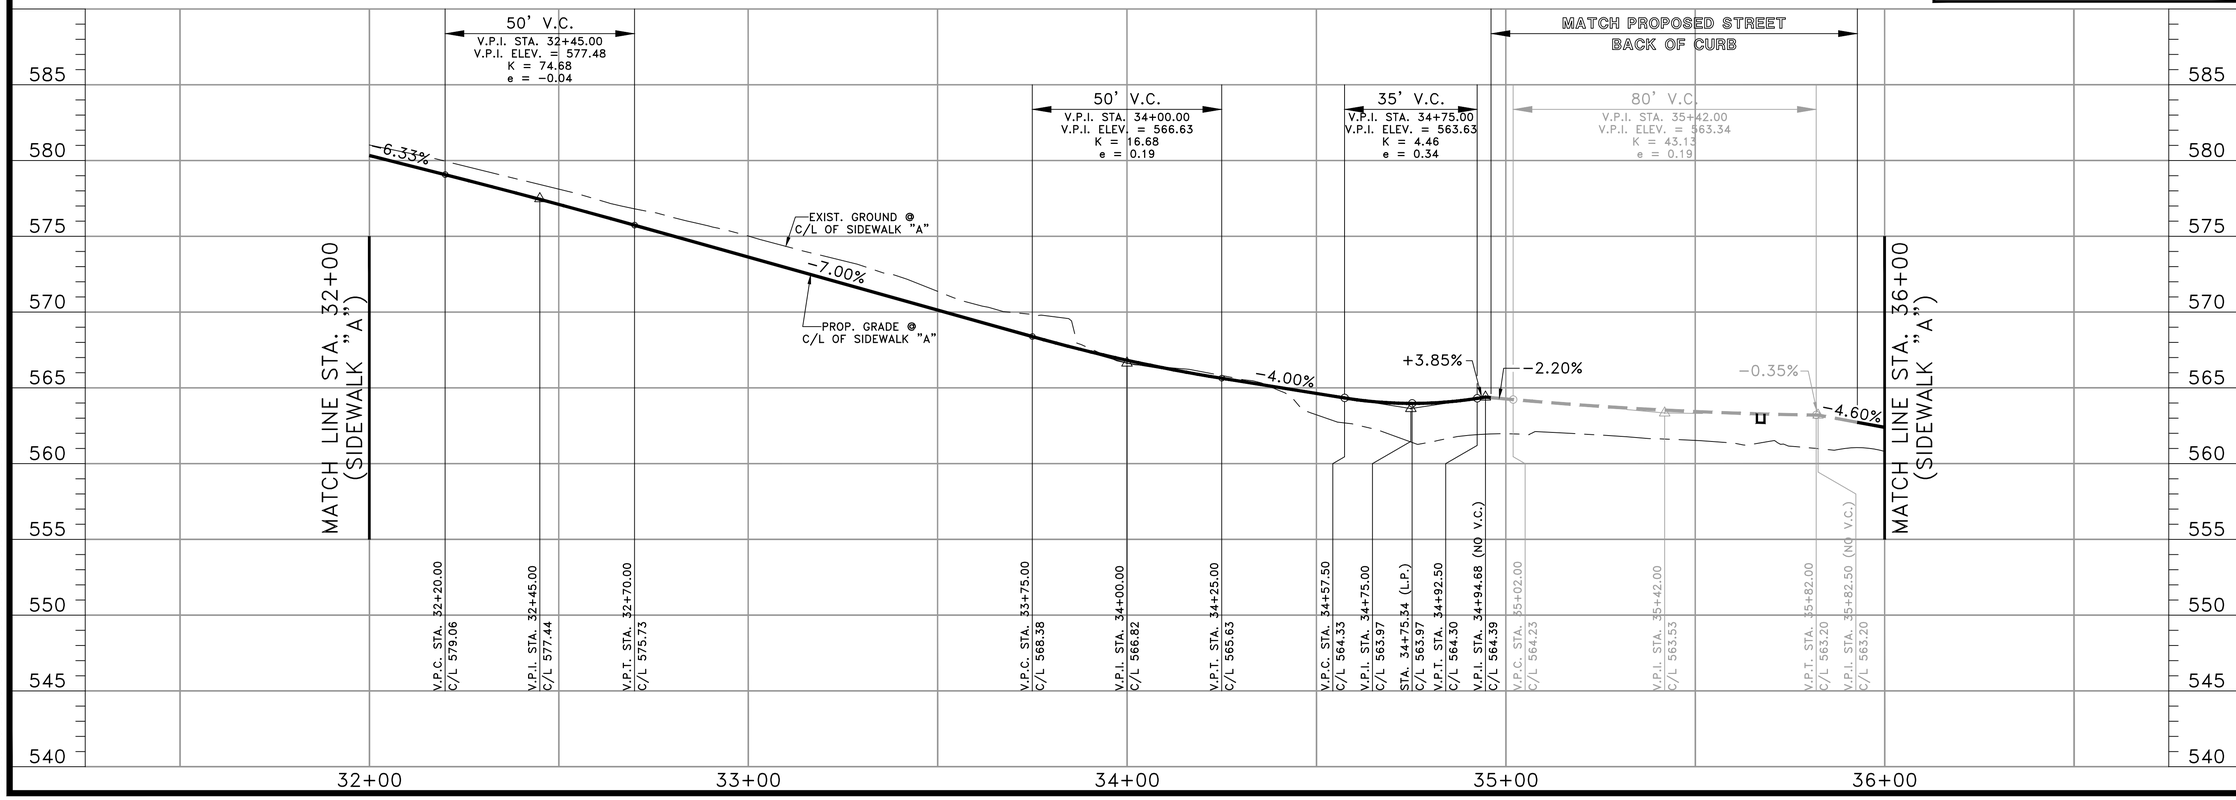

SCHAUMBURG & POLK, INC.
BEAUMONT I HOUSTON I RICHARDSON
KYLE I PORT ARTHUR I TERRELL I TYLER
2201 N. CENTRAL EXPRESSWAY, SUITE 205
Richardson, Texas 75080
(972) 864-8200 (T) (972) 864-8220 (F)
Firm Registration No. F-520

STATE OF TEXAS
JONATHAN D. WATKINS
130743
REGISTERED PROFESSIONAL
11-11-26

HIGHLAND SHORES BOULEVARD RECONSTRUCTION PROJECT
(FROM TWIN COVE DRIVE/HILLSIDE DRIVE TO 200'± WEST OF LAKE COVE)
SIDEWALK "A" - PLAN AND PROFILE
STA. 32+00 TO STA. 36+00
CITY OF HIGHLAND VILLAGE

NO.	DATE:	REVISION:	REVIEWED:
6	11/11/26	FILL WALL REMOVED	JDW
5			
4			
3			
2			
1			

SCALE: (H)1"=20', (V)1"=5'

DATE: SEPTEMBER 2026


DRAWN BY: SPI


REVIEWED BY: JDW

PROJECT NO: 23-2132

SHEET NO: 81

J:\23-2132 HIGHLAND SHORES REHAB\DRAWINGS DWG. NAME: 2132PP-SIDEWALK-A-09

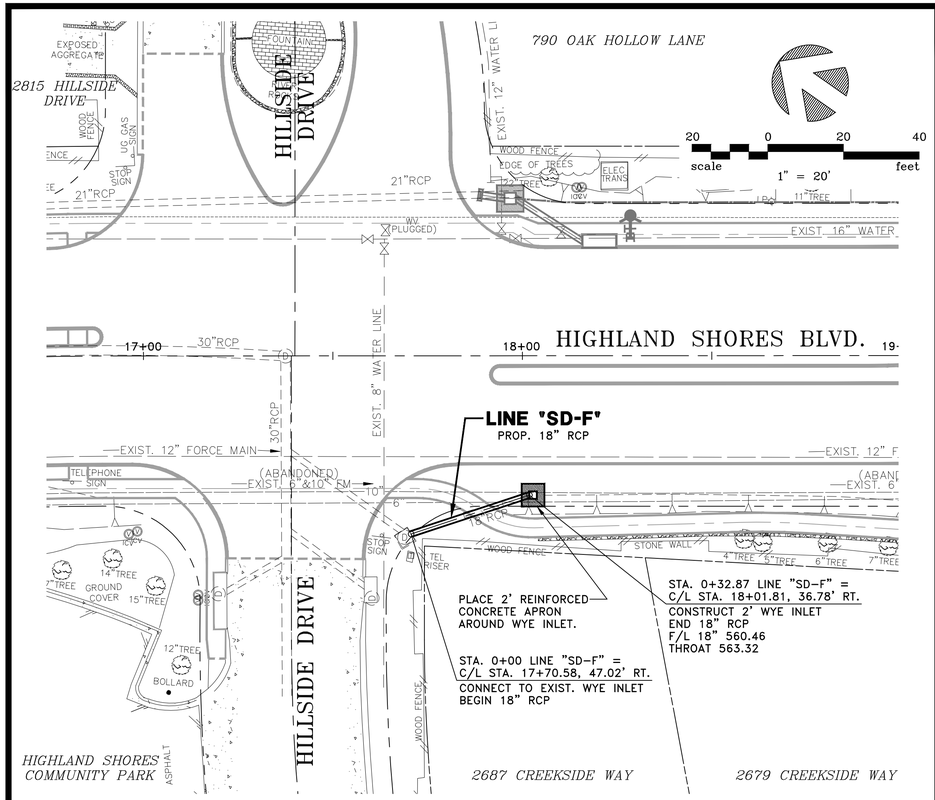


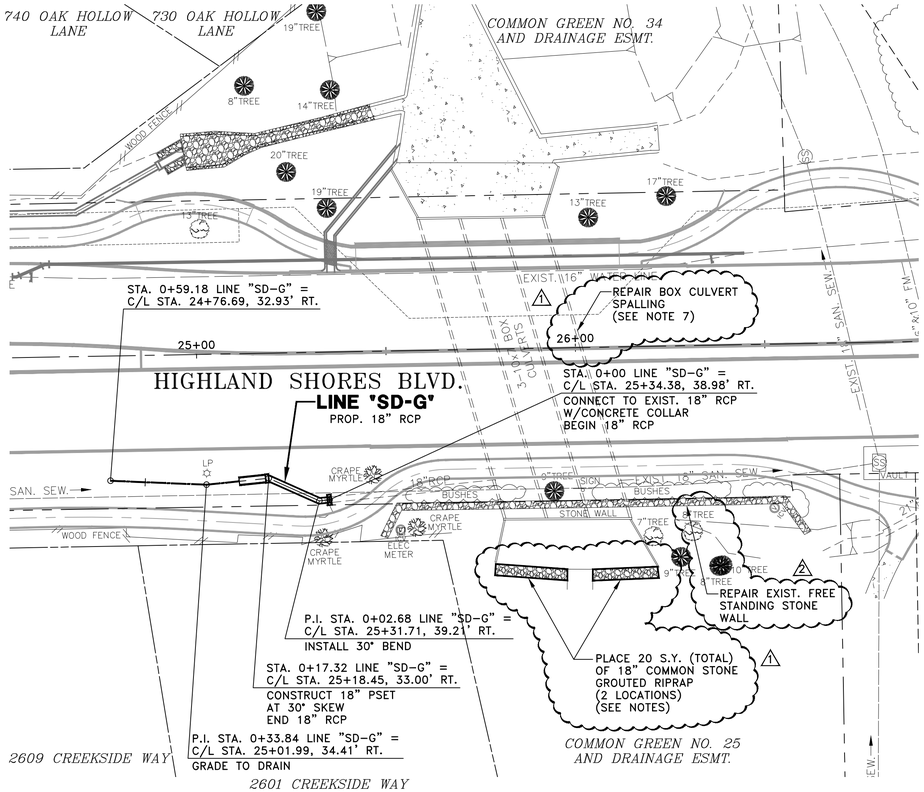


20 0 20 40
scale 1" = 20' feet

NOTES:

1. COMMON STONE GROUTED RIP RAP SHALL CONFORM TO CHANNEL SLOPES AND SHALL BE GRADED SO NO WATER PONDS.
2. COMMON STONE GROUTED RIP RAP SHALL INCLUDE AN 12" WIDE x 30" DEEP TOEWALL AT ALL EDGES OF THE RIP RAP AREA. TOEWALL MAY BE ELIMINATED WHEN ROCK IS ENCOUNTERED.
3. COMMON STONE GROUTED RIP RAP SHALL CONFORM TO TXDOT ITEM 432 AND SHALL BE 18" THICK. RIP RAP SHOULD INCLUDE FILTER FABRIC THAT CONFORMS TO TXDOT DMS-6200, TYPE 2.
4. FILTER FABRIC SHALL BE PLACED UNDER ALL AREAS OF THE RIP RAP PRIOR TO ROCK PLACEMENT. FILTER FABRIC SHALL BE MIRAFI-150N, OR APPROVED EQUAL, AND THE COST SHALL BE INCLUDED IN THE UNIT PRICE BID FOR COMMON STONE RIP RAP.
5. COMMON STONE GROUTED RIPRAP TOEWALL SHALL BE CONSIDERED SUBSIDIARY TO COMMON STONE RIPRAP. (NO SEPARATE PAY)
6. CONCRETE APRON SHALL BE 4" THICK 3,000 PSI WITH NO. 3 BARS AT 18" O.C.E.W. APRON SHALL HAVE A MINIMUM SLOPE OF 8:1.
7. CONTRACTOR SHALL REPAIR EXISTING BOX CULVERT SPALLING AREAS. REPAIR SHALL BE IN COMPLIANCE WITH TXDOT CONCRETE REPAIR MANUAL CHAPTER 3, AND CONFORM TO DMS-4655.

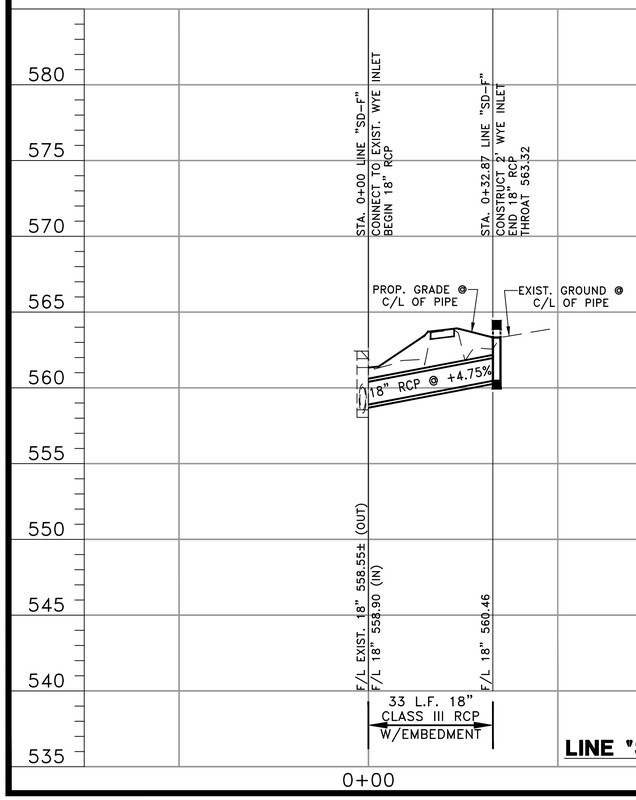

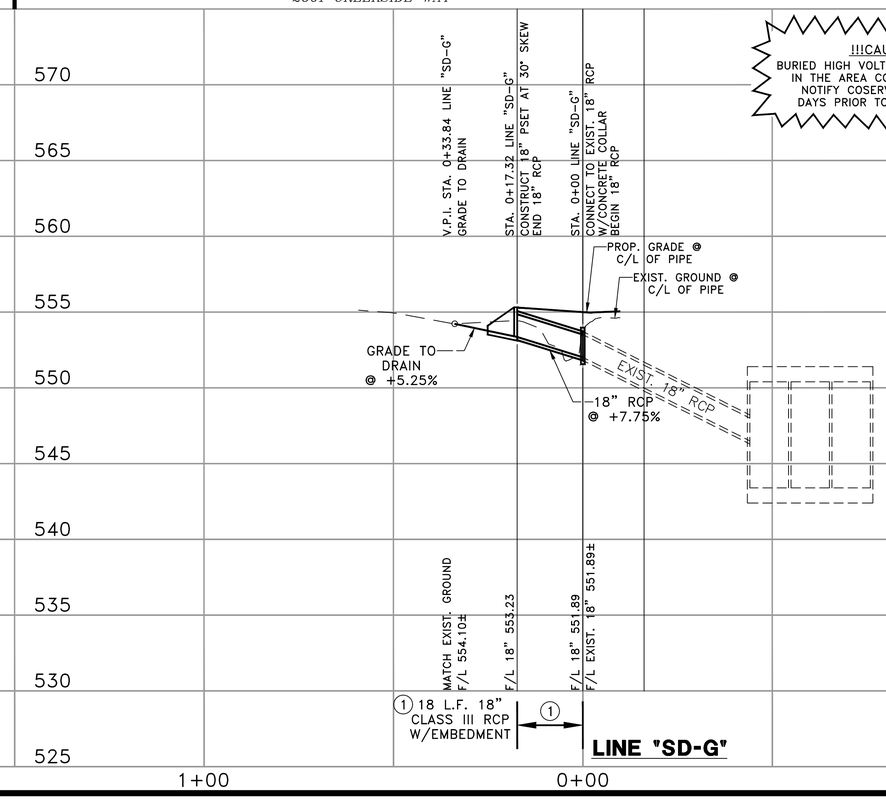

!!!CAUTION!!!
BURIED HIGH VOLTAGE ELECTRIC LINES IN THE AREA CONTRACTOR SHALL NOTIFY COSERV TWO WORKING DAYS PRIOR TO CONSTRUCTION.

!! CAUTION !!

THERE ARE EXISTING AND/OR PROPOSED UTILITIES IN PROJECT AREA. UTILITY INFORMATION SHOWN ON PLANS REPRESENTS APPROXIMATE LOCATIONS OF EXISTING UTILITIES AND IS NOT NECESSARILY ALL-INCLUSIVE. CONTRACTOR SHALL BE RESPONSIBLE FOR VERIFYING EXACT LOCATIONS OF ALL EXISTING UTILITIES AND SHALL BE REQUIRED TO PROTECT UTILITIES TO AVOID DAMAGE.

PRIOR TO ANY EXCAVATION, CONTRACTOR SHALL CONTACT TEXAS811 AND OTHERS AS REQUIRED TO LOCATE EXISTING UTILITIES.

CONTRACTOR SHALL ALSO CONTACT APPROPRIATE CITY UTILITY DEPARTMENT FOR FIELD LOCATES OF MUNICIPAL INFRASTRUCTURE 48 HOURS PRIOR TO CONSTRUCTION.

SCHAUMBURG & POLK, INC.
BEAUMONT I HOUSTON I RICHARDSON
KYLE I PORT ARTHUR I TERRELL I TYLER
2201 N. CENTRAL EXPRESSWAY, SUITE 205
Richardson, Texas 75080
(972) 864-8200 (T) (972) 864-8220 (F)
Firm Registration No. F-520

STATE OF TEXAS
JONATHAN D. WATKINS
130743
REGISTERED PROFESSIONAL
11-11-25

HIGHLAND SHORES BOULEVARD RECONSTRUCTION PROJECT
(FROM TWIN COVE DRIVE/HILLSIDE DRIVE TO 200'± WEST OF LAKE COVE)
DRAINAGE - PLAN AND PROFILE
LINE "SD-F" AND LINE "SD-G"
CITY OF HIGHLAND VILLAGE

NO.:	DATE:	REVISION:	REVIEWED:
6			
5			
4			
3			
2	11/11/26	STONE WALL	JDW
1	10/26/26	RIPRAP/BOX CULVERT	JDW

SCALE: (H)1"=20', (V)1"=5'

DATE: SEPTEMBER 2026


DRAWN BY: SPI


REVIEWED BY: JDW


PROJECT NO: 23-2132

SHEET NO: 100

DWG. NAME: 2132PP-DRAIN-S-03
J:\23-2132 HIGHLAND SHORES REHAB\DRAWINGS

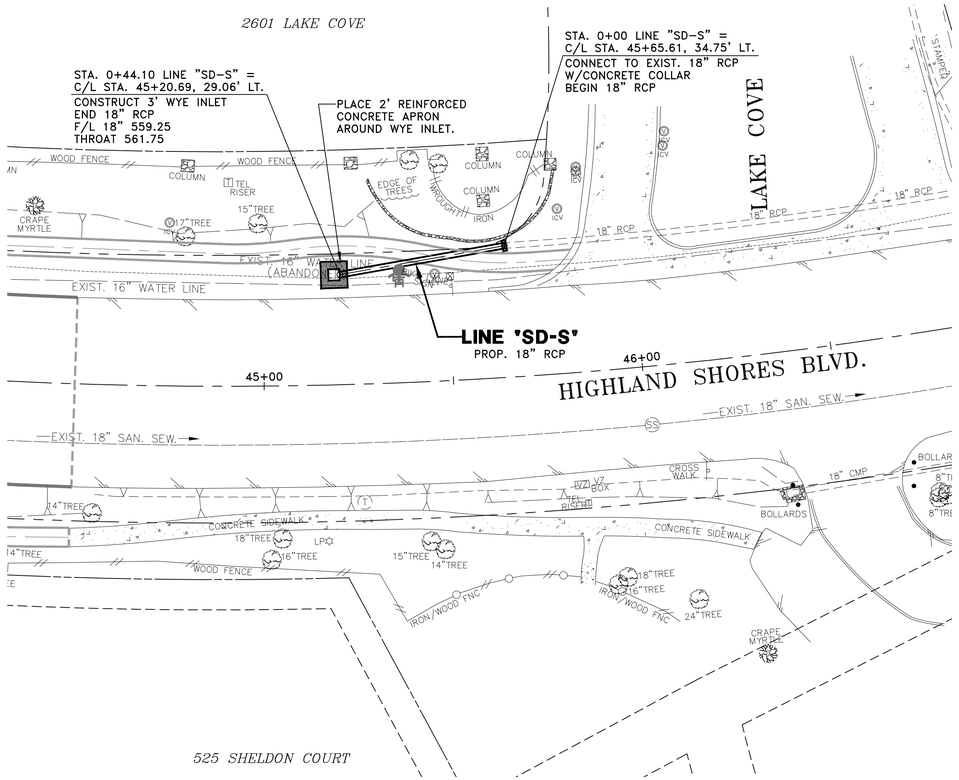


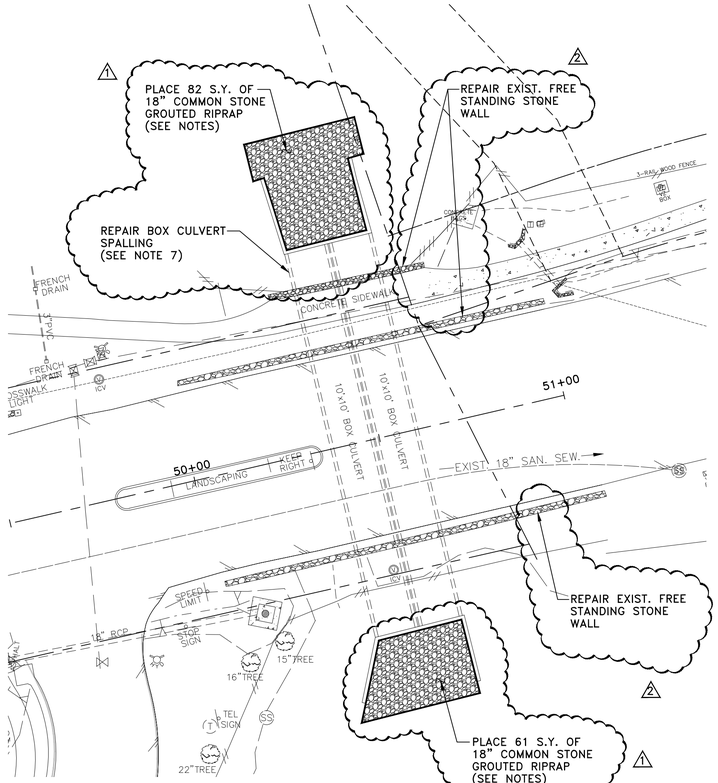

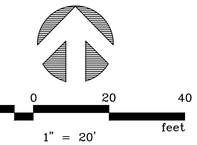

NOTES:

1. COMMON STONE GROUTED RIP RAP SHALL CONFORM TO CHANNEL SLOPES AND SHALL BE GRADED SO NO WATER PONDS.
2. COMMON STONE GROUTED RIP RAP SHALL INCLUDE AN 12" WIDE x 30" DEEP TOEWALL AT ALL EDGES OF THE RIP RAP AREA. TOEWALL MAY BE ELIMINATED WHEN ROCK IS ENCOUNTERED.
3. COMMON STONE GROUTED RIP RAP SHALL CONFORM TO TXDOT ITEM 432 AND SHALL BE 18" THICK. RIP RAP SHOULD INCLUDE FILTER FABRIC THAT CONFORMS TO TXDOT DMS-6200, TYPE 2.
4. FILTER FABRIC SHALL BE PLACED UNDER ALL AREAS OF THE RIP RAP PRIOR TO ROCK PLACEMENT. FILTER FABRIC SHALL BE MIRAFI-150N, OR APPROVED EQUAL, AND THE COST SHALL BE INCLUDED IN THE UNIT PRICE BID FOR COMMON STONE RIP RAP.
5. COMMON STONE GROUTED RIPRAP TOEWALL SHALL BE CONSIDERED SUBSIDIARY TO COMMON STONE RIPRAP. (NO SEPARATE PAY)
6. CONCRETE APRON SHALL BE 4" THICK 3,000 PSI WITH NO. 3 BARS AT 18" O.C.E.W. APRON SHALL HAVE A MINIMUM SLOPE OF 8:1.
7. CONTRACTOR SHALL REPAIR EXISTING BOX CULVERT SPALLING AREAS. REPAIR SHALL BE IN COMPLIANCE WITH TXDOT CONCRETE REPAIR MANUAL CHAPTER 3, AND CONFORM TO DMS-4655.

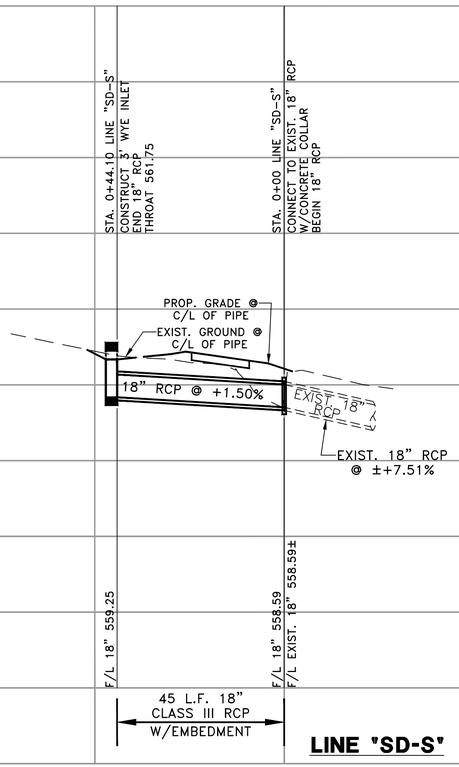

!!!CAUTION!!!
BURIED HIGH VOLTAGE ELECTRIC LINES IN THE AREA CONTRACTOR SHALL NOTIFY COSERV TWO WORKING DAYS PRIOR TO CONSTRUCTION.

!! CAUTION !!

THERE ARE EXISTING AND/OR PROPOSED UTILITIES IN PROJECT AREA. UTILITY INFORMATION SHOWN ON PLANS REPRESENTS APPROXIMATE LOCATIONS OF EXISTING UTILITIES AND IS NOT NECESSARILY ALL-INCLUSIVE. CONTRACTOR SHALL BE RESPONSIBLE FOR VERIFYING EXACT LOCATIONS OF ALL EXISTING UTILITIES AND SHALL BE REQUIRED TO PROTECT UTILITIES TO AVOID DAMAGE.

PRIOR TO ANY EXCAVATION, CONTRACTOR SHALL CONTACT TEXAS811 AND OTHERS AS REQUIRED TO LOCATE EXISTING UTILITIES.

CONTRACTOR SHALL ALSO CONTACT APPROPRIATE CITY UTILITY DEPARTMENT FOR FIELD LOCATES OF MUNICIPAL INFRASTRUCTURE 48 HOURS PRIOR TO CONSTRUCTION.

SPI
SCHAUMBURG & POLK, INC.
BEAUMONT | HOUSTON | RICHARDSON
KYLE | PORT ARTHUR | TERRELL | TYLER
2201 N. CENTRAL EXPRESSWAY, SUITE 205
Richardson, Texas 75080
(972) 864-8200 (T) (972) 864-8220 (F)
Firm Registration No. F-520

STATE OF TEXAS
JONATHAN D. WATKINS
130743
REGISTERED PROFESSIONAL ENGINEER
11-11-25
2

HIGHLAND SHORES BOULEVARD RECONSTRUCTION PROJECT
(FROM TWIN COVE DRIVE/HILLSIDE DRIVE TO 200'± WEST OF LAKE COVE)
DRAINAGE - PLAN AND PROFILE LINE "SD-S"
CITY OF HIGHLAND VILLAGE

NO.:	DATE:	REVISION:	REVIEWED:
1	11/11/26	STONE WALL	JDW
2	10/26/26	RIPRAP/BOX CULVERT	JDW

SCALE:
(H)1"=20', (V)1"=5'

DATE:
SEPTEMBER 2026

DRAWN BY:
SPI

REVIEWED BY:
JDW

PROJECT NO:
23-2132

SHEET NO:
110

J:\23-2132 HIGHLAND SHORES REHAB\DRAWINGS DWG. NAME: 2132PP-DRAIN-N-09